

Name Joseph Napoli

2031 Com. 9-9-46
Service No. 5 3102

Address 55 Gleason Road 3 Valley Rd

Lexington, Mass.

Location 3 Valley Road

Kind of Pipe

Size

Size of Main

~~Repair or Renewal~~ - New Service

Location

Date	Material	Amount	Total	Date	Location	Amount
Mar. 5, '46	Labor	20 52	20 52	Feb 18 '46	Deposited	45 00
	10% Overhead		2 05			
	31' - 3/4" Copper Tubing		5 63		Non-Charge	
	1 - 3/4" C. X 3/4" I.W.H. Stop & Waste		2 82	Mar. 15, '46	Labor	20 23
	Trucking 1 hr.		75	18' - 3/4" Copper Tubing		3 27
	Patching 14 x 3-		14 00	1 - 3/4" C. Corp-cock		2 70
	(No additional bill sent - bill less than \$1.00)		45 77	1 - 3/4" c x 3/4" C. Curb-cock		3 30
				1 - Box & Rod		1 65
				1 - 3/4" Straight Tail Piece		90
				1 - 3/4" Offset Tail Piece		90
				Compressor 6 hrs. @1.75		10.50
				Trucking 2 hrs. @/75		1 50
	Labor					44.95

Hadley Press, Inc., Lexington

DATE _____

TOWN OF LEXINGTON—BOARD OF PUBLIC WORKS

WATER DIVISION

The undersigned applies for a supply of water at No. _____ St. and hereby agrees to comply with the rules and regulations as now, or at any future time, established by the Board of Selectmen.


Am't. of Estimate \$ _____

Owner _____

Am't. Paid \$ _____

Address _____

Builder _____

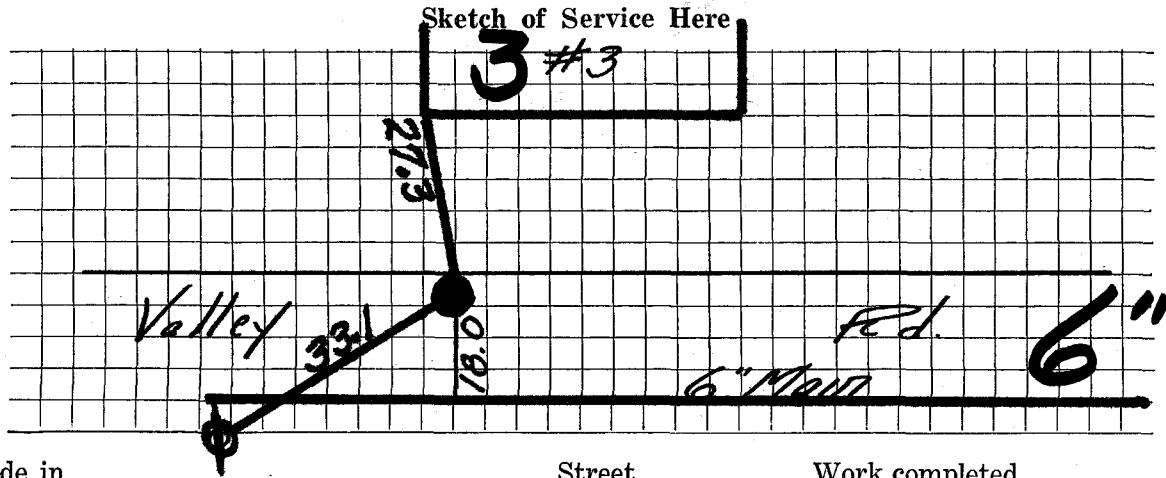

Connection made in _____ Street.

Work completed _____ 19

Remarks: