

## WATER SERVICE RECORD

1168

Service No. 6

Name Joseph E. Casey

Address 30 Valley Road

Location

Repairs—Renewal—New Service


Date	Material	Amount	Total	Date	Amount
4/3/56	Labor	1 90		1-24-56	Deposit \$ 35 00
	10% overhead	19	2 09	5-21-56	Paid 32 83
	42' - 3/4" Copper @ .4850		20 37		NON CHARGE 67 83
	1 - 3/4Cx $\frac{1}{2}$ I.W.H. Stop & Waste		4 96	4/3/56	Labor 1 90
	1 hr. trucking		75		8' - 3/4" Copper tubing @ .4850 3 88
	4 2/3 hrs. Littlefield Shovel @ 8.50-39		66	1 - 3/4 C. Corp Cock	4 34
			67 83	1 - 3/4 C. Curb Cock	6 03
				1 Box & Rod	4 62
				1 - $\frac{1}{2}$ Straight tailpiece	50
				1 - $\frac{1}{2}$ Offset tailpiece	50
				1 hr. Littlefield Shovel	8 50
					<u>30 27</u>

\* Paid by refund on S.F.C. #4

DATE \_\_\_\_\_

TOWN OF LEXINGTON — BOARD OF PUBLIC WORKS  
WATER DIVISION

Sketch of Service Here

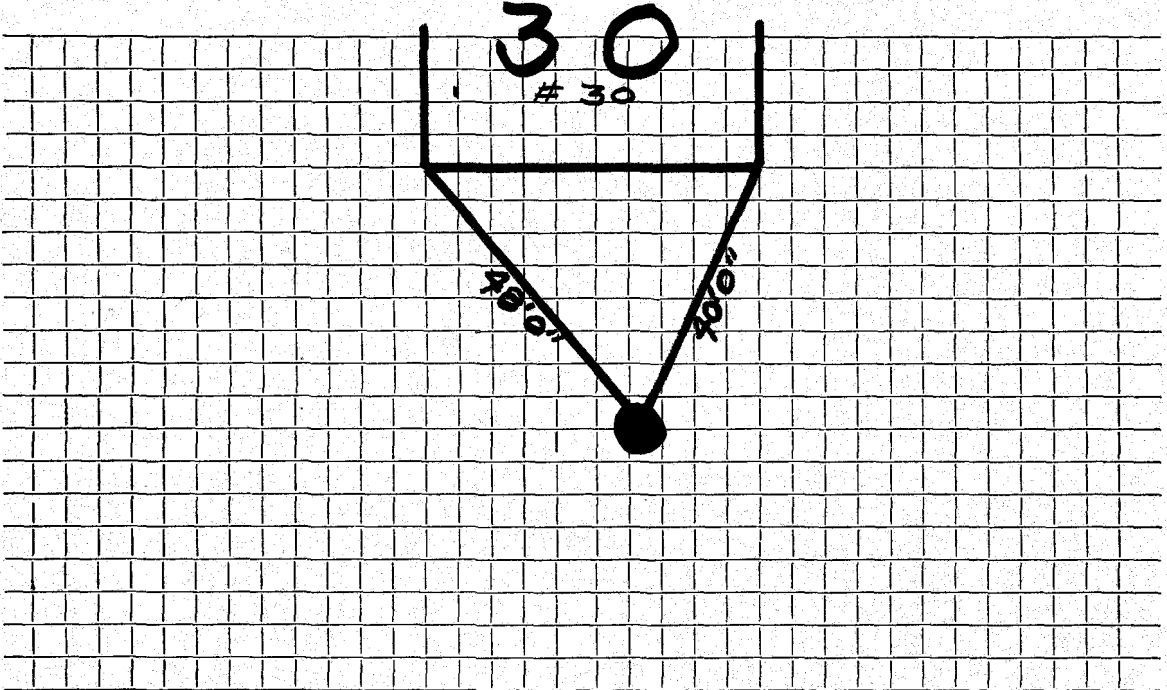

Connection made in ..... Street.      Work completed .....

Remarks: .....  
.....  
.....