

WATER SERVICE RECORD

Name **Leontine L. Beckett**

Service No. 335

479
#1814

Address **48 Valley Road**

Location **Lexington, Mass.**

~~REPAIR RECORD~~ - New Service


Com. 12-26-50

Date	Material	Amount	Total	Date	Amount
Oct. 27, '50	Labor	7 18	7 18	Oct. 27, '50	40 00
	10% Overhead		72		
	31' - 3/4" Copper Tubing @.32	9 92			No Charge
	1 - 3/4" C x 1/2" I.W.H. S&W	3 76		Oct. 27, '50	7 18
	Littlefield Shovel 1 hr. @ 7.00	7 00		9' - 3/4" Copper Tubing @.32	2 88
	Trucking 1 hr. @.75		75	1 - 3/4" Corp-cock	3 60
			29 33	1 - 3/4" C x 3/4" Curb-cock	4 40
				1 - Box & Rod	3 35
				1 - 1/2" Offset Tail Piece	42
				1 - 1/2" Straight Tail Piece	42
				Trucking 1 hr. @.75	75
					23 00

DATE _____

TOWN OF LEXINGTON — BOARD OF PUBLIC WORKS
WATER DIVISION

Sketch of Service Here

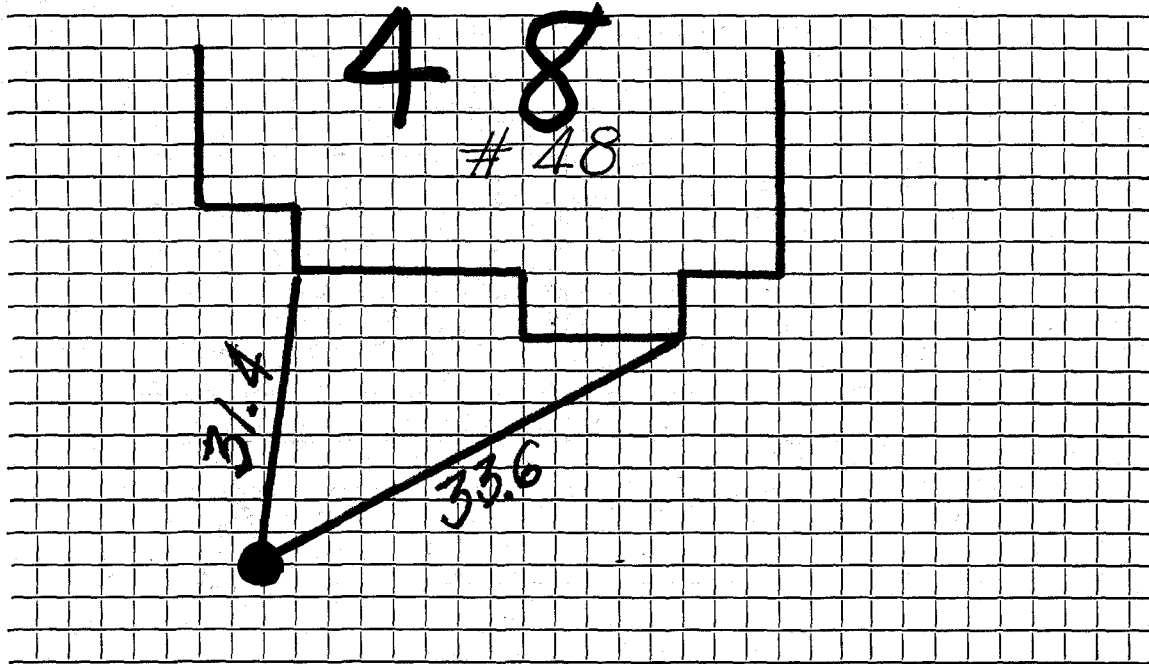

Connection made in Street. Work completed

Remarks:

.....
.....