

Name Donald K. Irwin

Service No.

240

Address 6 Valley Road

#5360

Lexington, Mass.

Location 6 Valley Road

Kind of Pipe

Size

Size of Main

~~Repair~~ ~~General~~ New Service

Com. 12-13-49

Location

Date	Material	Amount	Total	Date	Amount
Nov. 28, '49	Labor	1 35	1 35	Nov. 9 '49	20 00
	10% Overhead		14	Dec 22 '49	5 83
	36' - 3/4" Copper Tubing @.24	8 64	8 64		No Charge
	1 - 3/4"C x 1/2" I.S.H. S&W	3 29	3 29	Nov. 28, '49	Labor
	Trucking 1 hr. @.75		75		1 35
			14 17	16' - 3/4" Copper Tubing @.24	3 84
				1 - 3/4" C Corp-cock	3 15
				1 - 3/4"C x 3/4" Curb-cock	3 85
				1 - Box & Rod	3 75
				1 - 1/2" Offset Tail Piece	37
				1 - 1/2" Straight Tail Piece	37
				Trucking 1 hr. @.75	75
					17 43
	Labor				

DATE _____

TOWN OF LEXINGTON – BOARD OF PUBLIC WORKS

WATER DIVISION

The undersigned applies for a supply of water at No..... St. and hereby agrees to comply with the rules and regulations as now, or at any future time, established by the Board of Selectmen.

Am't of Estimate \$.....

Owner


Am't Paid \$.....

Address

Builder

.....

Sketch of Service Here

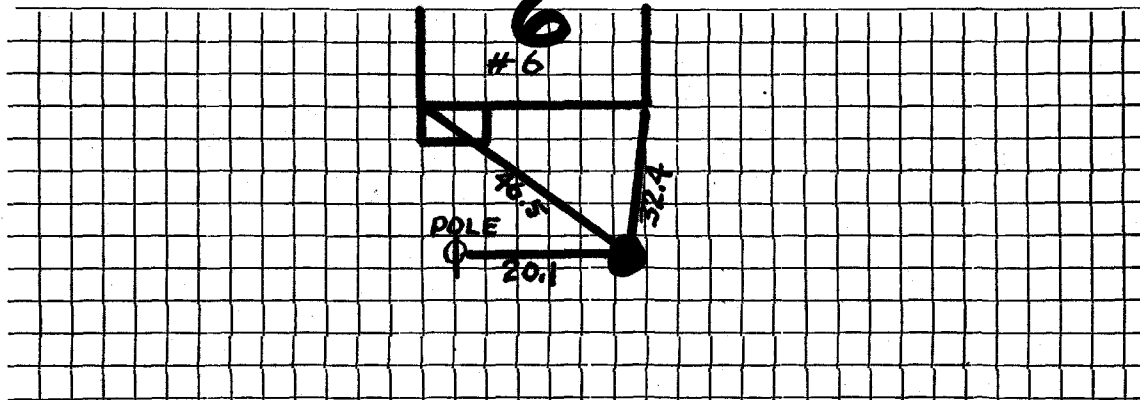

Connection made in Street.

Work completed19

Remarks: