

8754
 Name Theresa Massucco

WATER SERVICE RECORD

Service No. 339

Address 62 Valley Road

7796

Location Lexington, Mass.

~~Repair~~—Renewal—~~New Service~~


Com. 12-31-50

Date	Material	Amount	Total	Date	Amount	
Oct. 27, '50	Labor	6 97	6 97	Oct. 30 '50	Reported	25 00
	10% Overhead		70			13 16
	10' - 3/4" Copper Tubing @.334	3 34	3 34		No Charge	22 52
	1 - 3/4" C x 1/2" I.W.H. S&W	3 76	3 76	Oct. 27, '50	Labor	6 97
	Littlefield Shovel 1 hr. @7.00	7 00	7 00	5' - 3/4" Copper Tubing @.334		1 67
	Trucking 1 hr. @.75		75	1 - 3/4" C Corp-cock		3 60
			22 52	1 - 3/4" C x 3/4" C Curb-cock		4 40
				1 - Box & Rod		3 35
				1 - 1/2" Offset Tail Piece		42
				1 - 1/2" Straight Tail Piece		42
				Trucking 1 hr. @.75		75
						21 58

DATE _____

TOWN OF LEXINGTON — BOARD OF PUBLIC WORKS
WATER DIVISION

Sketch of Service Here

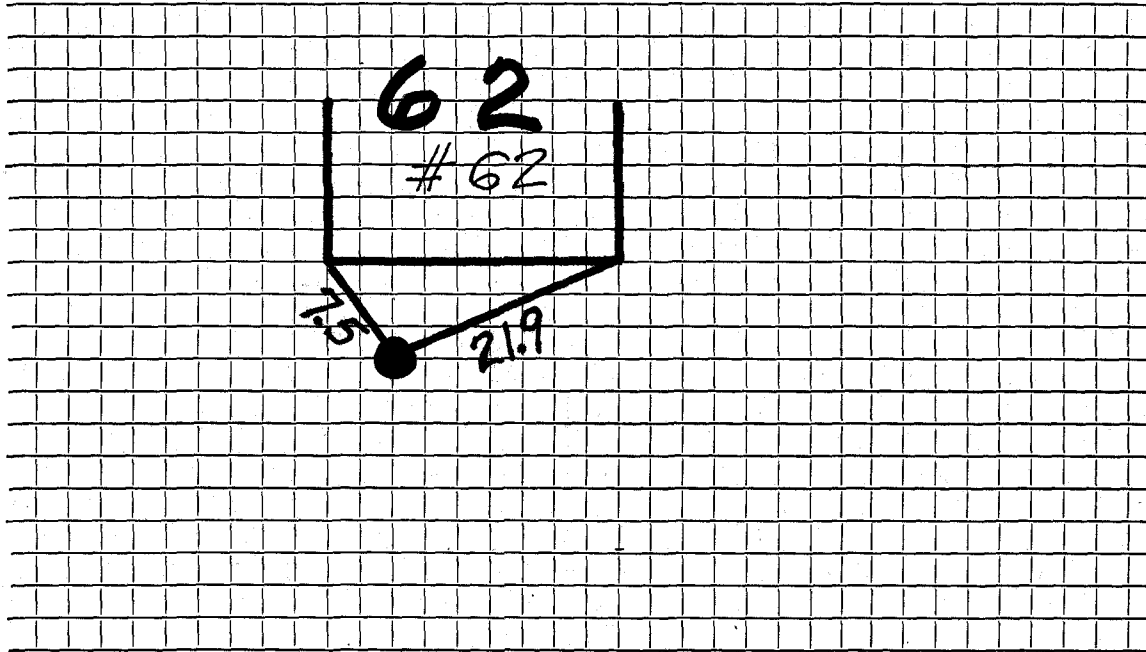

Connection made in Street. Work completed

Remarks:
.....
.....