

WATER SERVICE RECORD

Name McCullough

Service No.

Address 67 Valley Road


Location Lexington, Mass.

~~Repair~~ - Renewal - ~~New Service~~

| Date | Material | Amount | Total | Date | Amount |
|------|----------|--------|-------|---------------------|-------------------------------|
| | | | | | |
| | | | | | |
| | | | | | |
| | | | | | No Charge |
| | | | | 10-27-50 | Labor 1 50 |
| | | | | 24' | 3/4" Copper Tubing @.334 8 02 |
| | | | | 1 - 3/4" C | Yorp-cock 3 60 |
| | | | | 1 - 3/4" C x 3/4" C | Gurb-cock 4 40 |
| | | | | 1 - Box | & Rod 3 35 |
| | | | | Trucking 1 hr. | @.75 75 |
| | | | | | 21 62 |
| | | | | | |
| | | | | | |
TOWN OF LEXINGTON — BOARD OF PUBLIC WORKS
WATER DIVISION

Sketch of Service Here

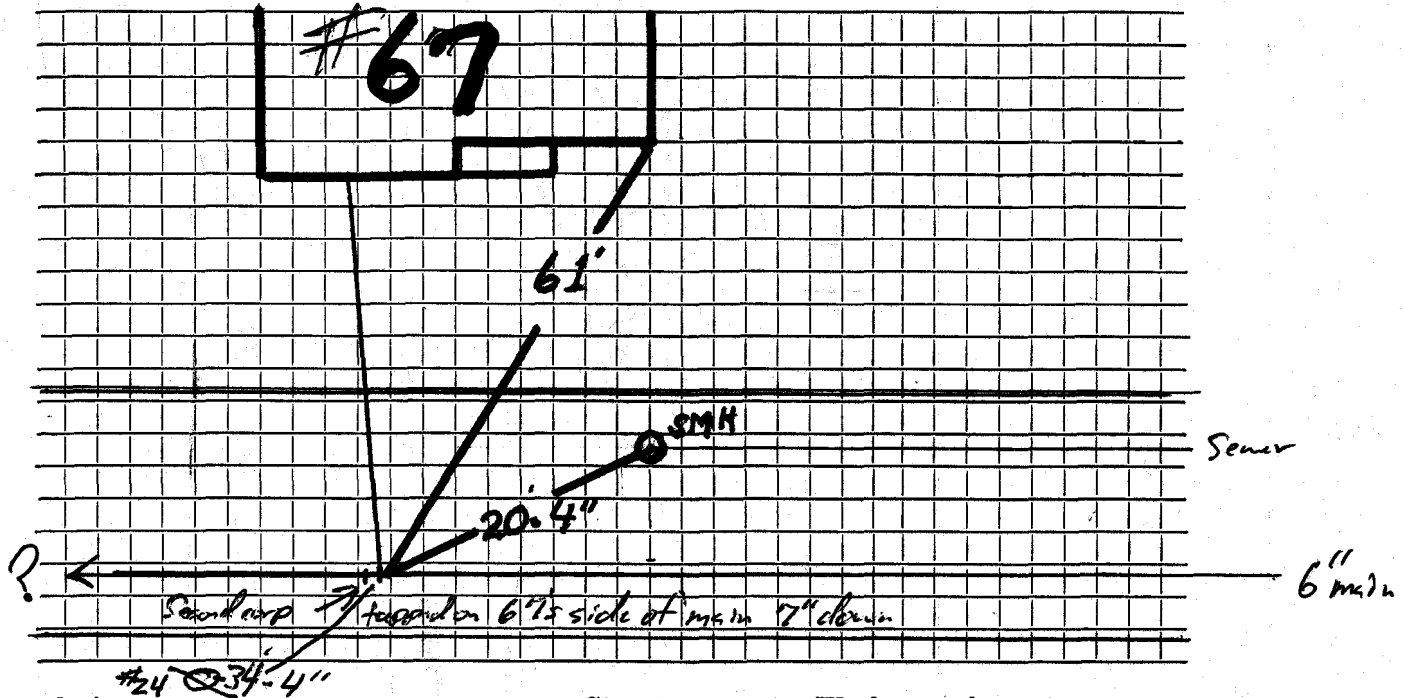

Connection made in Street. Work completed

Remarks: *A second corp is to be laid 7" down on the sewer side of main
 3'-6" deep*