




DATE 6/26/90  
P.A.B

TOWN OF LEXINGTON — BOARD OF PUBLIC WORKS

**WATER DIVISION**

Sketch of Service Here

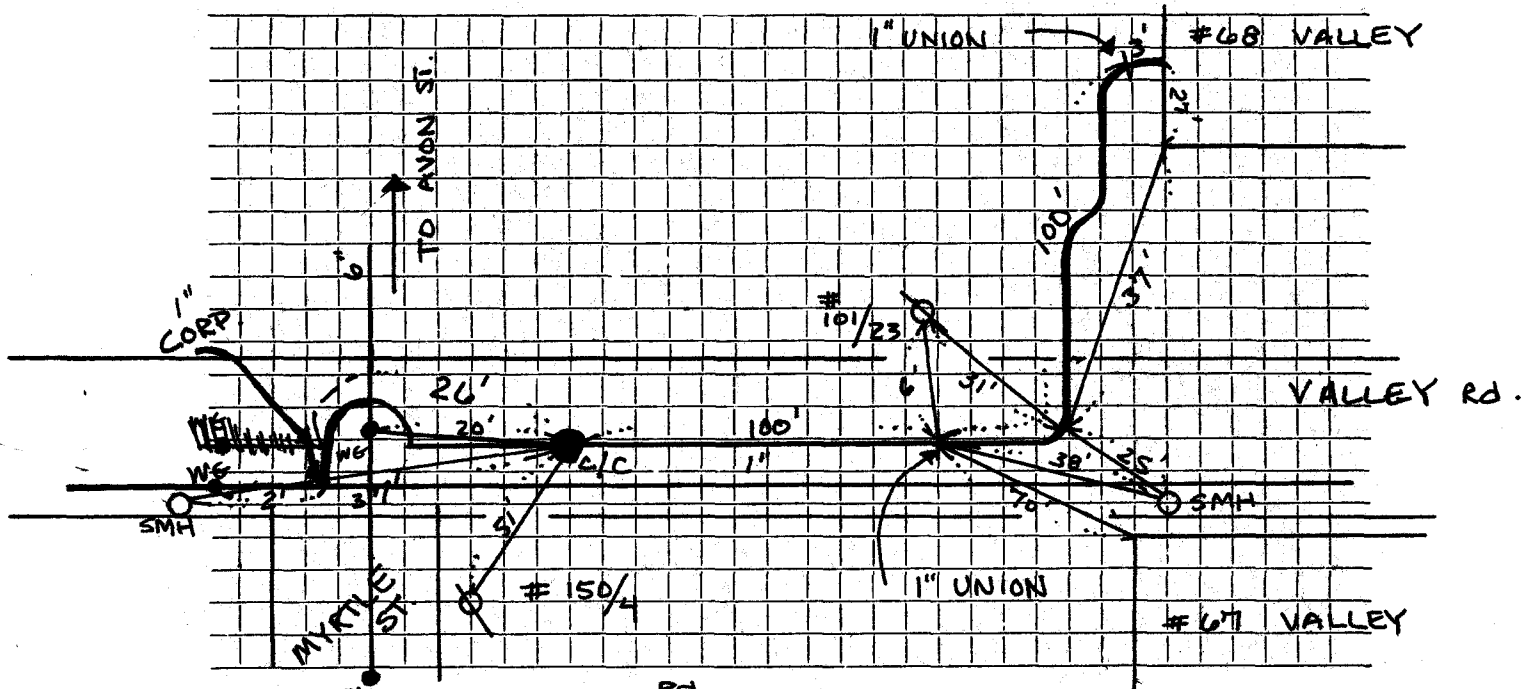

Connection made in ..... VALLEY ..... Rd. Street. Work completed .....

Remarks: INSPECTOR: P.A. BARROWS  
CONTRACTOR: A. CIERI & SONS