

WATER SERVICE RECORD

# 4965

Service No. 103 # 4966

Name **Albert K. Peirce**

Address **9 Valley Road**

Location **Lexington**

Repair ~~Renewal~~ <sup>Renewal</sup> ~~New Service~~ *Com. 6-16-52*


| Date    | Material  | Amount | Total | Date                                  | Amount |
|---------|---|--------|-------|---------------------------------------|--------|
| 4/30/52 | Labor   | 1 63   |       |                                       |        |
|         | 10% Overhead  | 17     | 1 80  |                                       |        |
|         | 54' - 3/4" Copper Tubing @.3439                             | 18 57  |       | 6-16-52<br>10-4-54                    |        |
|         | 1 -3/4" C x 1/2 I.W.H. Stop & Waste                         | 4 00   |       |                                       |        |
|         | 1 hr. trucking  |        | 75    | 4/30/52                               | Labor  |
|         |   |        | 25 12 |                                       |        |
|         |   |        |       | 15' -3/4" Copper tubing @.3439        | 5 15   |
|         |   |        |       | 1 -3/4" C. <sup>Comp.</sup> curb-cock | 4 33   |
|         |   |        |       | 1 -3/4" C x3/4" curb-cock             | 4 67   |
|         |   |        |       | 1 box & rod                           | 4 52   |
|         |   |        |       | 1 -1/2 Offset tail Piece              | 50     |
|         |   |        |       | 1 -1/2 Straight tail piece            | 50     |
|         |   |        |       | 1 hr. trucking                        | 75     |
|         |   |        |       |                                       | 24 83  |
|         | SERVICE LOWERED AND 3 PART UNION INSTALLED 21' IN FROM CURB |        |       |                                       |        |
|         |   |        |       | <i>bill sent 6-17-52</i>              |        |

DATE \_\_\_\_\_

TOWN OF LEXINGTON — BOARD OF PUBLIC WORKS

WATER DIVISION

Sketch of Service Here

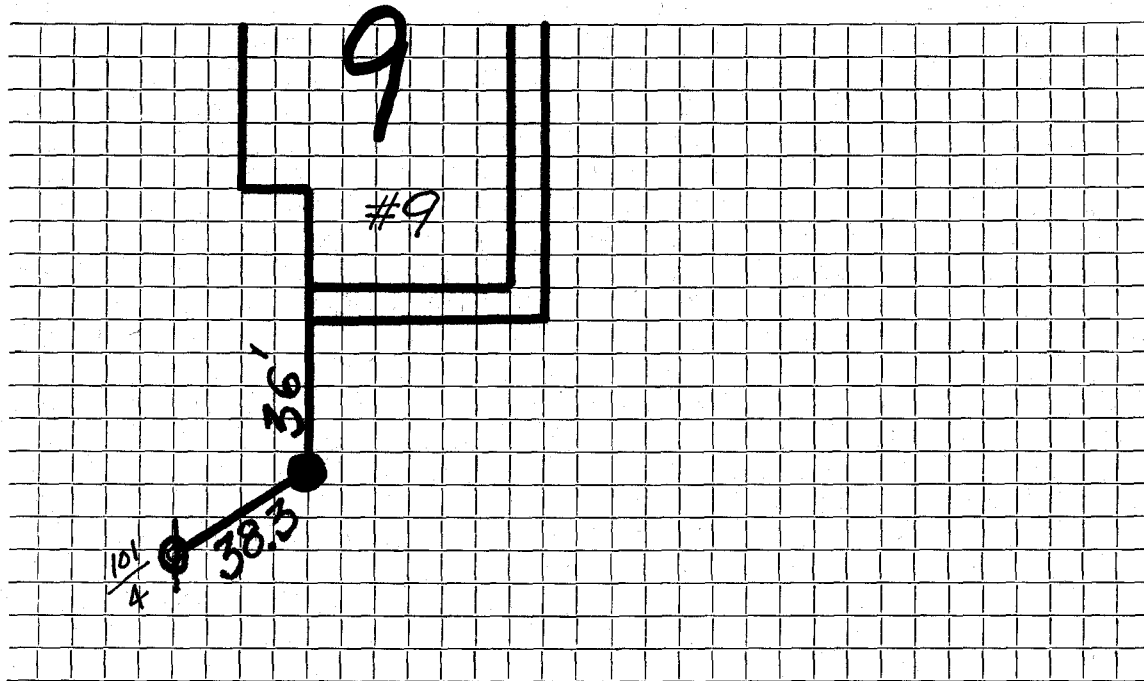

Connection made in ..... Street. Work completed .....

Remarks: .....

.....

.....