

WATER SERVICE RECORD

Name **Stratvern Realty**Service No. **43**Address **41 Vallyfield Street**Location **Sta. 4+14 Right - Lot #171**~~Repair/Replacement~~ **New Service W.O. #5515 Valeri #1745****DEC 31 1970**


Date	Material	Amount	Total	Date	Amount
10/19/67	Labor	13 80		10-2-70	64 92
	10% O.H.	1 38	15 18		
	24' 3/4" copper tubing @ .79		18 96		
	1 3/4" Curb		8 76		
	1 3/4" Corporation		7 42		
	1 Box & Rod		5 10		
	1 Hr. Shovel		6 50		
	1 Hr. Trucking		3 00		
			64 92		
10/7/70	39' 3/4" Copper tubing				

DATE _____

TOWN OF LEXINGTON — BOARD OF PUBLIC WORKS

WATER DIVISION

Sketch of Service Here

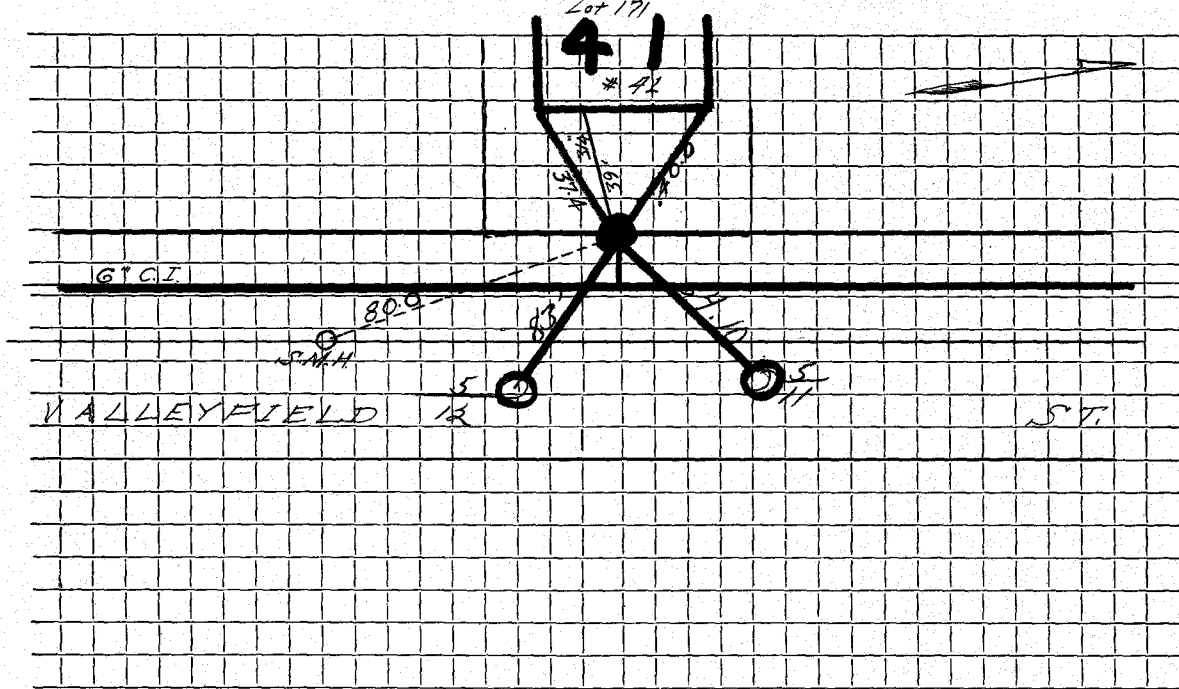

Connection made in Street. Work completed

Remarks:

.....

.....