

## WATER SERVICE RECORD

1332 #4435

Name Donna Realty

Service No. 91

Address 42 Valleyfield Street

Location Lot #97 Sta.4+14

Repair—Renewal—New Service Valeri #923

MAY 13 1968


Date		Material	Amount	Total	Date	Amount
12-21-67	45'	3/4" Copper tubing			12-20-67	99 91
10-25-67		Labor	26.61			
		10% O.H.	2.66	29.27		
	34'	3/4" Copper tubing @79		26.86		
	1	3/4" Corp Cock		7.42		
	1	3/4" Curb Cock		8.76		
	1	Box & Rod		5.10		
	1	hr. Trucking		3.00		
	3	hrs. Belli Bros. Gradall		19.50		
				99.91		

DATE \_\_\_\_\_

TOWN OF LEXINGTON — BOARD OF PUBLIC WORKS

WATER DIVISION

Sketch of Service Here

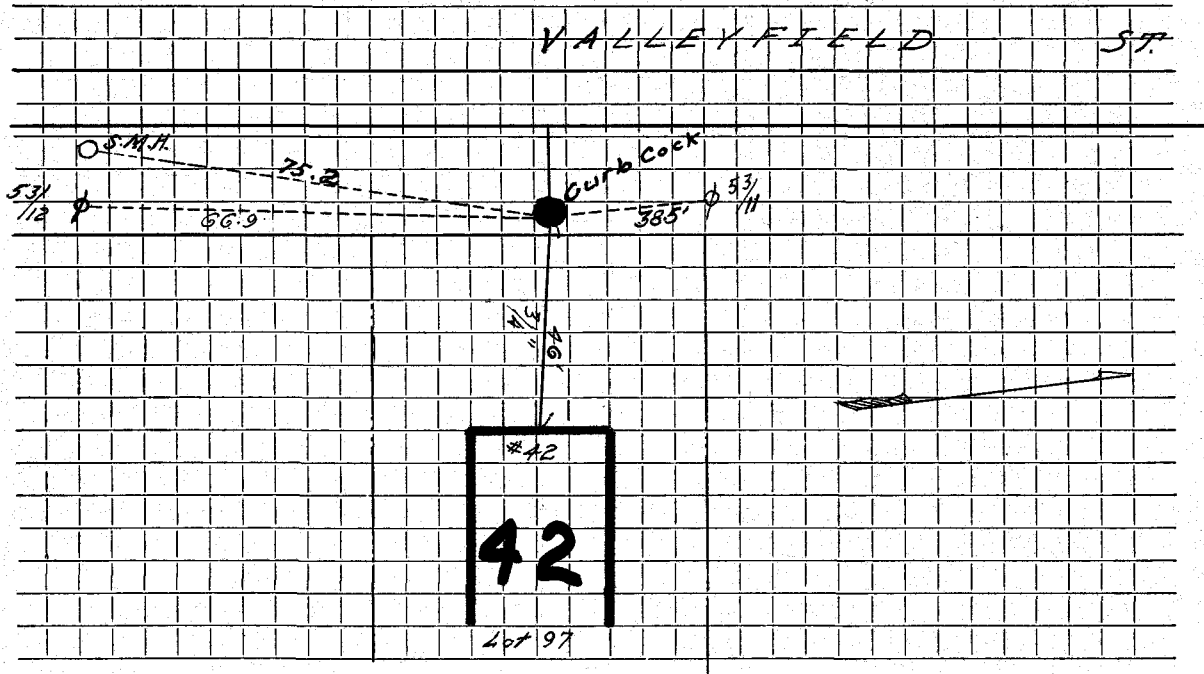

Connection made in ..... Street. Work completed .....

Remarks: .....  
.....  
.....