

Name

Service No. ¹⁵⁸

3395

Address 50 Valleyfield Street

Location 50 Valleyfield Street

Kind of Pipe

Size

Size of Main

~~Renewal~~ New Service

Cm 12-1-47

Location

Date	Material	Amount	Total	Date	Amount
Oct. 27, '47	Labor	9 40	9 40	Oct. 27, '47	7 20
	10% Overhead		94	Dec. 4, '47	14 92
	34' - 3/4" Copper Tubing @ .26	8 84			30 08
	1 - 3/4" C x 1/2" I. W.H. S & W	3 15		Oct. 27, '47	7 20
	Hired Shovel 1 hr. @ 7.00	7 00		25' - 3/4" Copper Tubing @ .26	6 50
	Trucking 1 hr. @ .75	75		1 - 3/4" C Corp-cock	3 00
			30 08	1 - 3/4" C x 3/4" C Curb-cock	3 68
				1 - Box & Rod	4 26
				1 - 1/2" Straight Tail Piece	30
				1 - 1/2" Offset Tail Piece	30
				Trucking 1 hr. @ .75	75
					<u>25 89</u>
	Labor				

Reputed
 Reputed
 Non-Charge

DATE _____

TOWN OF LEXINGTON - BOARD OF PUBLIC WORKS

WATER DIVISION

The undersigned applies for a supply of water at No..... St. and hereby agrees to comply with the rules and regulations as now, or at any future time, established by the Board of Selectmen.

Am't of Estimate \$.....


Owner

Am't Paid \$.....

Address

Builder

Sketch of Service Here

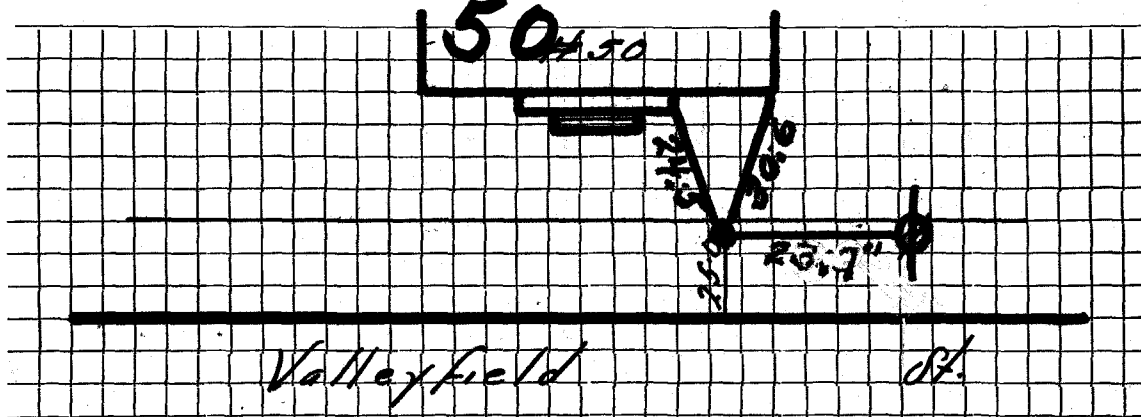

Connection made in Street.

Work completed19

Remarks: