

WATER SERVICE RECORD

Name Thomas Leyne

Service No. 20

Address 54 Valleyfield Street

Location

~~Repair/Replace~~ - New Service Devine #3408 W.O. #686

SEP 17 1979


Date	Material	Amount	Total	Date	Amount
9/10/79	156' 1" Copper tubing (inside)			8-15-79	300.00
	31' 6" 1" Copper tubing (outside)			9-21-79	138.09
8/27/79	Labor	130.08			438.11
	10% O.H.	13.01	143.09		
	31' 1" Copper tubing @.90		27.90		
	1 1" Corp.		19.65		
	1 1" Curb		24.18		
	1 Box & Rod		13.50		
	5 yds. Gravel @3.50		17.50		
	1/4 ton Stone @4.50		1.13		
	3 hrs. Trucking @3.00		9.00		
	3 hrs. Backhoe @6.50		19.50		
	Hot Top 5' x 11' Sidewalk		36.66		
	Hot Top 7' x 27' Street		126.00		
			438.11		

DATE _____

TOWN OF LEXINGTON — BOARD OF PUBLIC WORKS

WATER DIVISION

54 Sketch of Service Here

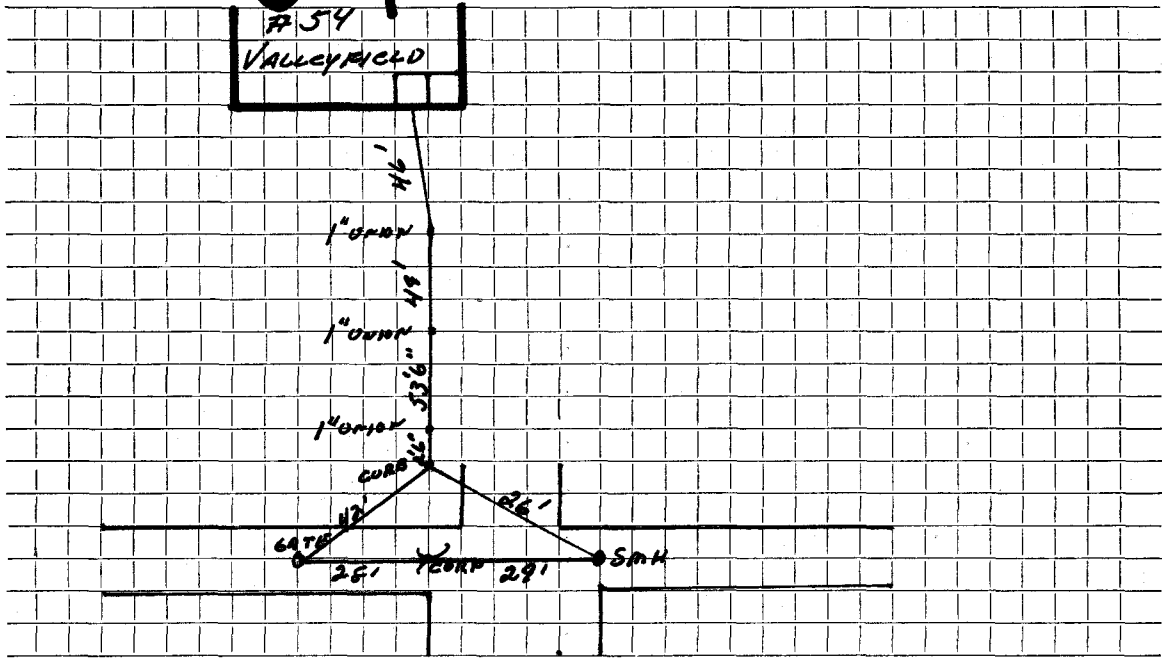

Connection made in Street. Work completed

Remarks:
.....
.....