

Name ~~John Valijira~~

Francis J. Rosa

#4472 #3562
Service No. 216
#5443

Address 58 Valleyfield Street

Lexington, Mass.

Location 58 Valleyfield Street

Kind of Pipe

Size

Size of Main

~~Repair-Renewal~~—New Service

Com. 11-6-50

Location

Date	Material	Amount	Total	Date	Amount
Sept. 8, '50	Labor	2 60	2 60	Aug 10 '50	35 00
	10% Overhead		26		
	32' - 3/4" Copper T.,bing @.275		8 80		
	1 - 3/4"C x 1/2" I.W.H. S&W		3 29		
	Littlefield Shovel 2 hrs. @ 7.00		14 00		
	Trucking 1 hr. @ .75		75		
			29 70		
				Sept. 8, '50	
				Labor	4 75
				25' - 3/4" Copper Tubing @.275	6 88
				1 - 3/4" Corp-cock	3 15
				1 - 3/4"C x 3/4"C Curb-cock	3 85
				1 - Box & Rod	3 35
				1 - 1/2" Offset Tail Piece	42
				1 - 1/2" Straight Tail Piece	42
				Littlefield Shovel 2 hrs. @7.00	14 00
				Trucking 1 hr. @ .75	75
	Labor				32 57

Hadley Press, Inc., Lexington

DATE _____

TOWN OF LEXINGTON—BOARD OF PUBLIC WORKS

WATER DIVISION

The undersigned applies for a supply of water at No. _____ St. and hereby agrees to comply with the rules and regulations as now, or at any future time, established by the Board of Selectmen.

Am't. of Estimate \$ _____


Owner _____

Am't. Paid \$ _____

Address _____

Builder _____

Sketch of Service Here

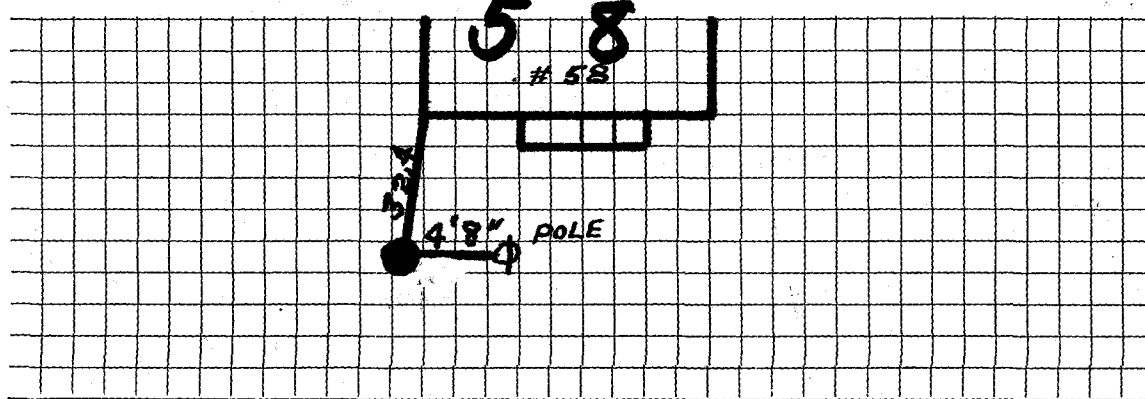

Connection made in _____ Street.

Work completed _____ 19

Remarks: