

WATER SERVICE RECORD

5453

Name **Ralph Masciulli**

Service No. 14

Address 59 Valleyfield Street

Location Sta. 8+52 Right - Lot #43

~~Repair/Renewal~~—New Service W.O. #5520 Valeri #1870

JUL 26 1971

Date		Material	Amount		Total		Date	Amount	
6/4/71	46'	3/4" Copper tubing					6-3-71	Deposit	63 96
10/19/67		Labor	14	36					
		10% O.H.	1	44	15	80			
	1	3/4" Curb			8	76			
	1	3/4" Corp			7	42			
	1	Box & Rod			5	10			
	1	Hr. Shaovel			6	50			
	1	Hr. Trucking			3	00			
	22'	copper tubing @ .79			17	38			
					63	96			


DATE _____

TOWN OF LEXINGTON — BOARD OF PUBLIC WORKS

WATER DIVISION

59

Sketch of Service Here

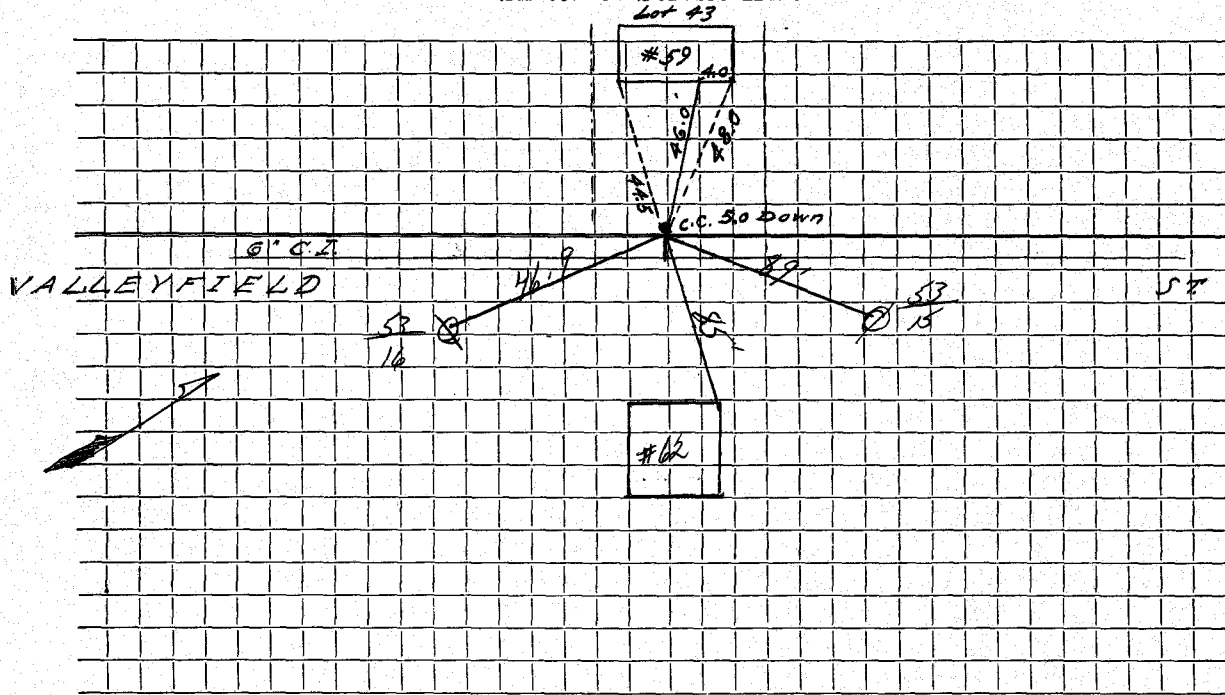

Connection made in Street. Work completed

Remarks:
.....
.....