

## WATER SERVICE RECORD

Name George Pierce

Service No. 31

Address 63 Valleyfield Street

Location Sta. 9+45 Right - Lot #45

~~REPAIR LICENSE~~ - New Service W.O. #5522 Valeri #2333

NOV 19 1973


Date	Material	Amount	Total	Date	Amount	
8/7/73	45' 3/4" Copper tubing			8-6-73	Deposit	58 34
10/19/67	Labor	13 80				
	10% O.H.	1 38	15 18			
	22' 3/4" copper tubing @.79		17 38			
	1 3/4" Curb		8 76			
	1 3/4" Corp		7 42			
	1 hr. Shovel		6 50			
	1 Hr. Trucking		3 00			
			58 24			

DATE \_\_\_\_\_

TOWN OF LEXINGTON — BOARD OF PUBLIC WORKS

**WATER DIVISION**

Sketch of Service Here

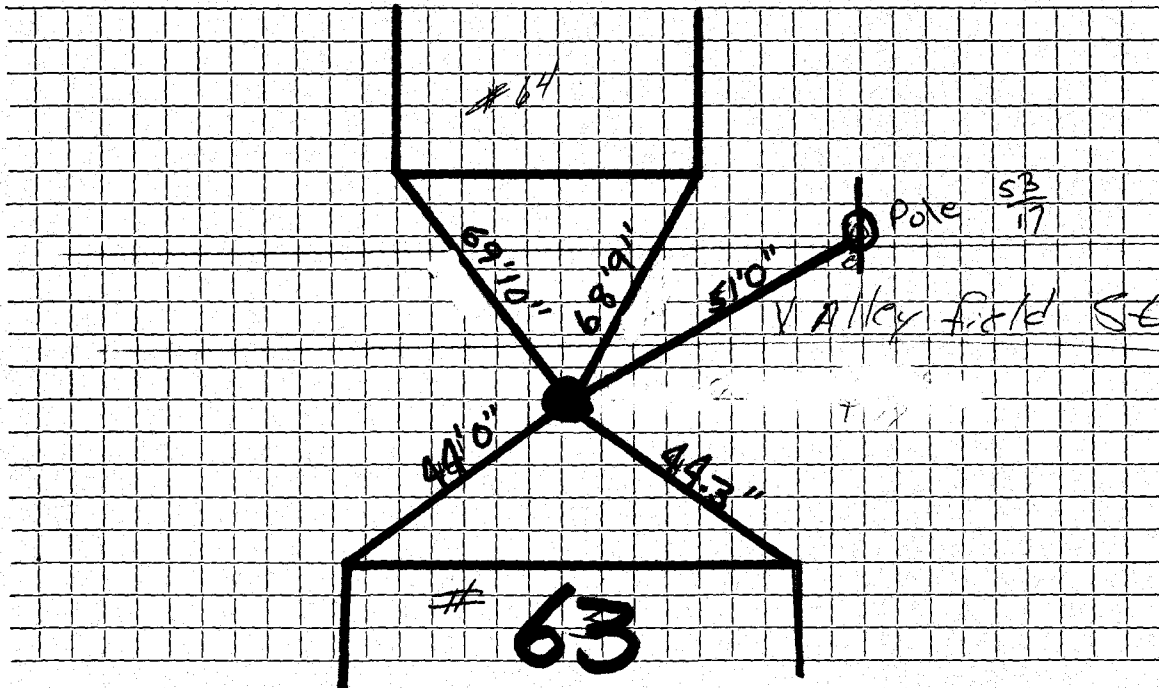

Connection made in ..... Street. Work completed .....

Remarks: .....

.....  
.....