

Name **Anna Valihura**Service No. ¹⁵⁰ **3393**Address **64 Valleyfield Street**Location **64 Valleyfield Street**

Kind of Pipe

Size

Size of Main

~~NEW SERVICE~~ **New Service***Com 12-1-47*

Location

Date	Material	Amount	Total	Date	Amount
Oct. 22, '47	Labor	9 40	9 40	<i>Oct 22 '47</i>	<i>Deposited</i> 40 00
	10% Overhead		94	<i>Dec 4 '47</i>	<i>Refunded</i> 9 40
	36' - 3/4" Copper Tubing @ .26		9 36		Non-Charge 30 60
	1 - 3/4" C x 1/2" I.W.H. S & W		3 15	Oct. 22, '47	Labor 9 10
	Hired Shovel 1 hr. @ 7.00		7 00	28' - 3/4" Copper Tubing @ .26	7 28
	Trucking 1 hr. @ .75		75	1 - 3/4" C Corp-cock	3 00
			30 60	1 - 3/4" C x 3/4" C Curb-cock	3 68
				1 - Box & Rod	4 26
				1 - 1/2" Straight Tail Piece	30
				1 - 1/2" Offset Tail Piece	30
				Trucking 1 hr. @ .75	75
					<u>28 67</u>
	Labor				

DATE _____

TOWN OF LEXINGTON - BOARD OF PUBLIC WORKS

WATER DIVISION

The undersigned applies for a supply of water at No..... St. and hereby agrees to comply with the rules and regulations as now, or at any future time, established by the Board of Selectmen.

Am't of Estimate \$.....

Owner

Am't Paid \$.....


Address

Builder

.....

64

Sketch of Service Here

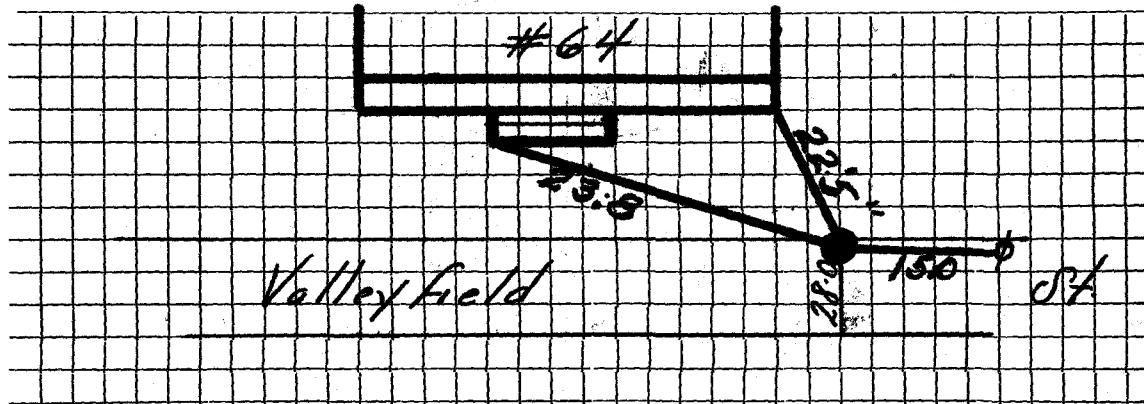

Connection made in Street.

Work completed19

Remarks: