

WATER SERVICE RECORD

Name

Service No.

Address 65 Valleyfield Street

Location Sta. 10+0 Right - Lot #46

~~Repair - Renewal~~ New Service W.O. #5523


Date	Material	Amount	Total	Date	Amount
		16 89			
10/5/67	Labor	16 89			
	10% O.H.	1 89	18 99		
15'	3/4" copper tubing @ .79		11 85		
1	3/4" Curb		8 76		
1	3/4" Corp		7 42		
1	Box & Rod		5 10		
1	3 part union		3 05		
			<u>54 76</u>		

DATE _____

TOWN OF LEXINGTON — BOARD OF PUBLIC WORKS

WATER DIVISION

Sketch of Service Here

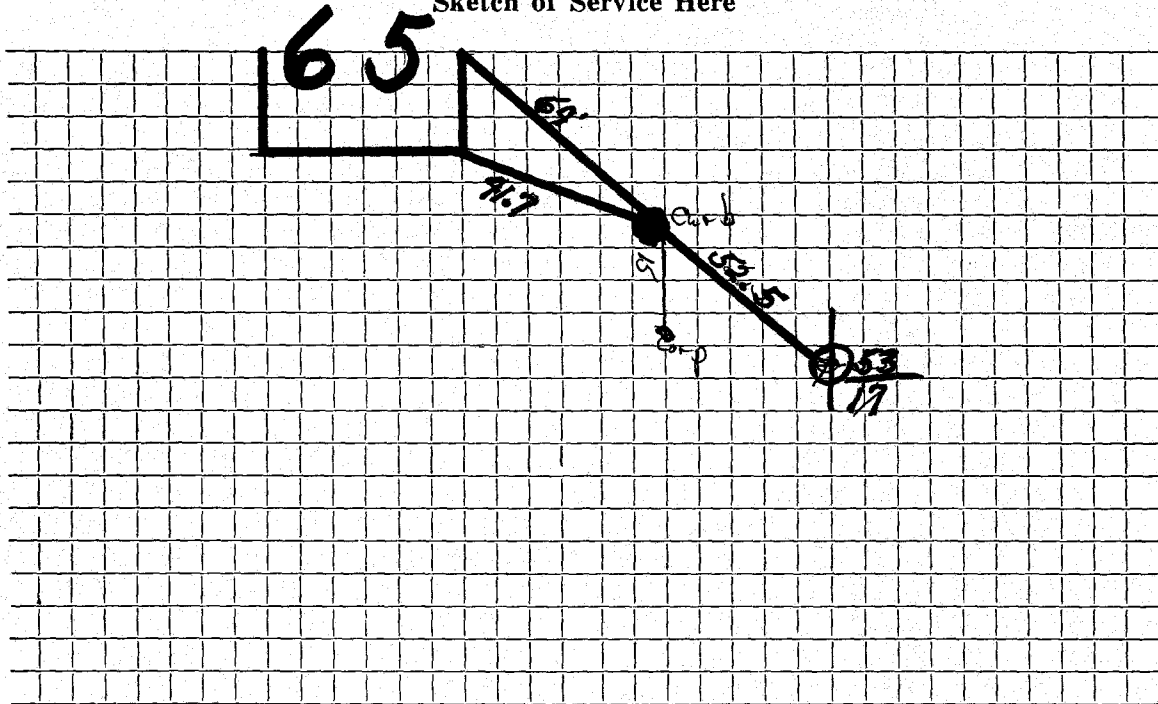

Connection made in Street. Work completed

Remarks:

.....

.....