

Name Joseph R. Belcik

1221

Service No.

3

Address 69 Valleyfield Street

Lexington, Mass.

Location

69 Valleyfield Street

Kind of Pipe

Size

Size of Main

~~Renewal~~ New Service Com. 2-21-49

Location

Date	Material	Amount	Total	Date	Amount
Jan. 7, '49	Labor	4 30	4 30	Jan. 5, '49	50 00
	10% Overhead		43	Feb. 24, '49	6 90
	45' - 3/4" Copper Tubing @.27		12 15		1/3 10
	1 - 3/4" C x 1/2" I.W.H. S&W		3 15	Jan. 7, '49	15 90
	1 - 3/4" C x 3/4" C Union (3pts)		1 32	15' - 3/4" Copper Tubing @.27	4 05
	Littlefield Shovel 3 hrs. @7.00		21 00	1 - 3/4" C Corp-cock	3 00
	Trucking 1 hr. @.75		75	1 - 3/4" C x 3/4" C Curb-cock	3 68
			43 10	1 - Box & Rod	3 55
				1 - 1/2" Offset Tail Piece	30
				1 - 1/2" Straight Tail Piece	30
				Littlefield Shovel 3 hrs. @7.00	21 00
				Trucking 1 hr. @.75	75
	Labor				52 53

DATE _____

TOWN OF LEXINGTON – BOARD OF PUBLIC WORKS

WATER DIVISION

The undersigned applies for a supply of water at No..... St. and hereby agrees to comply with the rules and regulations as now, or at any future time, established by the Board of Selectmen.

Am't of Estimate \$.....

Owner


Am't Paid \$.....

Address

Builder

.....

Sketch of Service Here

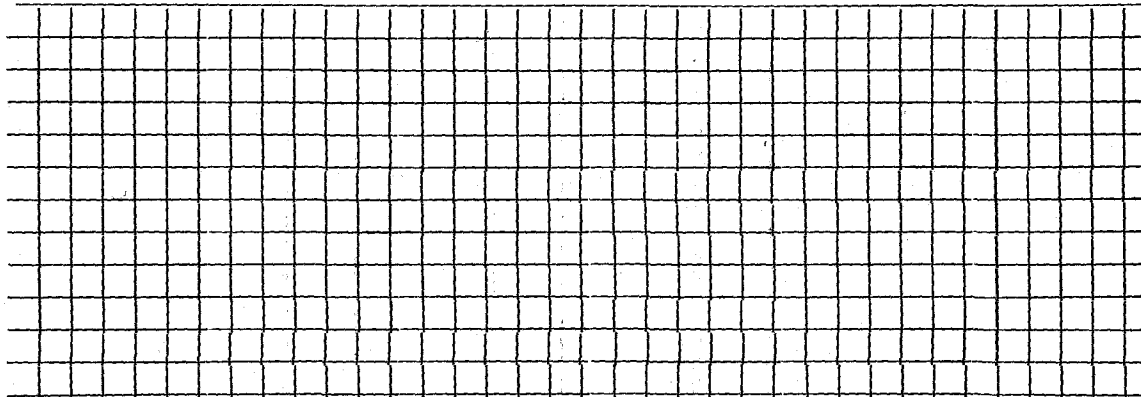

Connection made in Street.

Work completed19

Remarks: