

## WATER SERVICE RECORD

Name

Service No.

Address 70 Valleyfield Street

Location Lot #85 Sta. 10+40 left

Repair—Renewal—New Service W.O.#5525


Date	Material	Amount	Total	Date	INSIDE	Amount
10-23-67	Labor		22.39	10-8-93	paid	86.35
12'	3/4" Copper tubing @.79		33.18	10/19/93		
1	3/4" Corp Cock		7.42	68	3/4 COPPER	
1	3/4" Curb Cock		8.76			
1	box & rod		5.10			
1	hrs. Trucking		3.00			
1	hr. Backhoe		6.50			
			86.35			

DATE \_\_\_\_\_

TOWN OF LEXINGTON — BOARD OF PUBLIC WORKS

**WATER DIVISION**

Sketch of Service Here

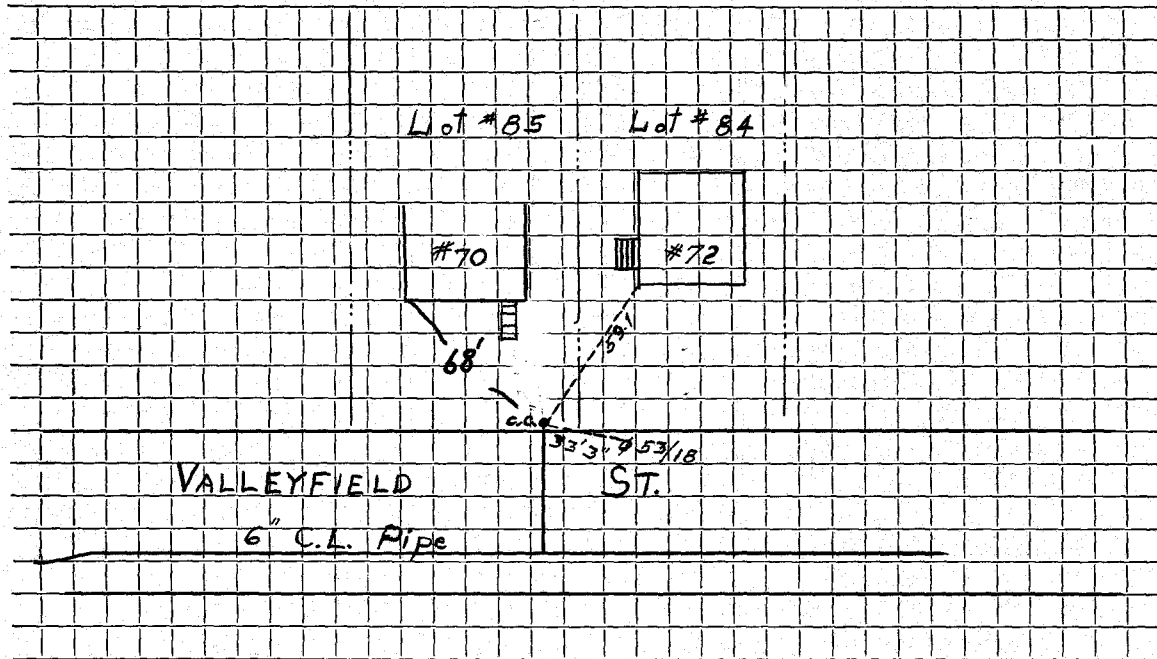

Connection made in ..... Street.      Work completed .....

Remarks: .....  
.....  
.....