

Name Frank Cuccinello

1025

Service No.

151 8894

Address 72 Valleyfield StreetLocation 72 Valleyfield Street

Kind of Pipe

Size

Size of Main

~~NEW SERVICE~~ - New Service

Com. 12-1-47

Location

Date	Material	Amount	Total	Date	Amount	
Oct. 22, '47	Labor	13 66	13 66	Oct 22 '47	Deposited	35 00
	10% Overhead		1 37	24	"	30 00
	52' - 3/4" Copper Tubing @.26	13 52	13 52	Dec 4 '47	Refunded	65 00
	1 - 3/4" C x 1/2" I.W.H. S & W	3 15	3 15		Non-Charge	25 53 39 46
	Hired Shovel 1 hr. @ 7.00	7 00	7 00	Oct 22, '47	Labor	10 22
	Trucking 1 hr. @.75		75	29' - 3/4" Copper Tubing @.26		7 54
			39 45	1 - 3/4" C Corp-cock		3 00
				1 - 3/4" C x 3/4" C Curb-cock		3 68
				1 - Box & Rod		4 26
				1 - 1/2" Straight Tail Piece		30
				1 - 1/2" Offset Tail Piece		30
				Trucking 1 hr. @.75		75
	Labor					30 05

DATE _____

TOWN OF LEXINGTON – BOARD OF PUBLIC WORKS

WATER DIVISION

The undersigned applies for a supply of water at No..... St. and hereby agrees to comply with the rules and regulations as now, or at any future time, established by the Board of Selectmen.

Am't of Estimate \$.....

Owner


Am't Paid \$.....

Address

Builder

.....

Sketch of Service Here

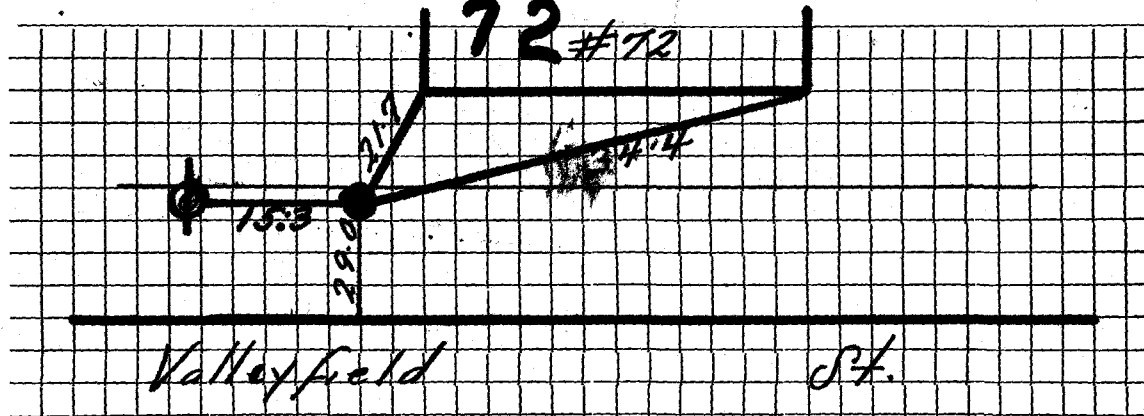

Connection made in Street.

Work completed19

Remarks: