

WATER SERVICE RECORD

Name Volunteer Assoc Realty Trust

Service No. 37

Address 78 Valleyfield Street

Location Sta.12+48 left Lot #81

Repair—Renewal—New Service Lexington Sewerage #1113

AUG 5 1968

Date	Material	Amount	Total	Date	Amount
10-3-67	Installed by Town		61.54	5-15-68	61.54
7-16-68	26' 3/4" Copper tubing				


Deposit

DATE _____

TOWN OF LEXINGTON — BOARD OF PUBLIC WORKS

WATER DIVISION

Sketch of Service Here

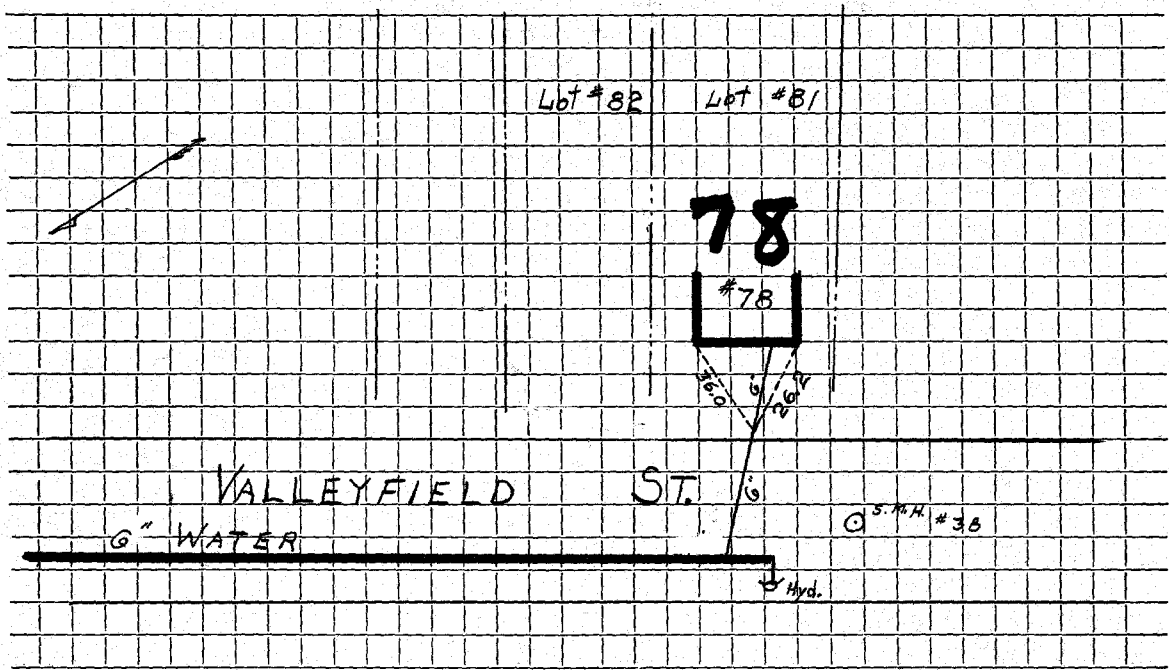

Connection made in Street. Work completed

Remarks:
.....
.....