

WATER SERVICE RECORD

Name **R. J. Foley**

Service No. **12**

Address **2 Viles Road**

3194

Location **Lot 1 Sta. 5+0**

Repair—Renewal—New Service **DeFlice #989**

AUG 5 1968


Date	Material	Amount	Total	Date		Amount
10-8-62	10' 3/4" Copper tubing @.42		4.20	4-18-68	Deposit	33.31
			<u>29.11</u>			
5-2-68	52' 3/4" Copper tubing		33.31			
					CURB TO MAIN	
				31'	3/4" Copper tubing @.42	13.02
				1	3/4" C Corp Cock	4.91
				1	3/4" C Curb Cock	6.28
				1	Box & Rod	<u>4.90</u>
						29.11

DATE _____

TOWN OF LEXINGTON — BOARD OF PUBLIC WORKS

WATER DIVISION

Sketch of Service Here

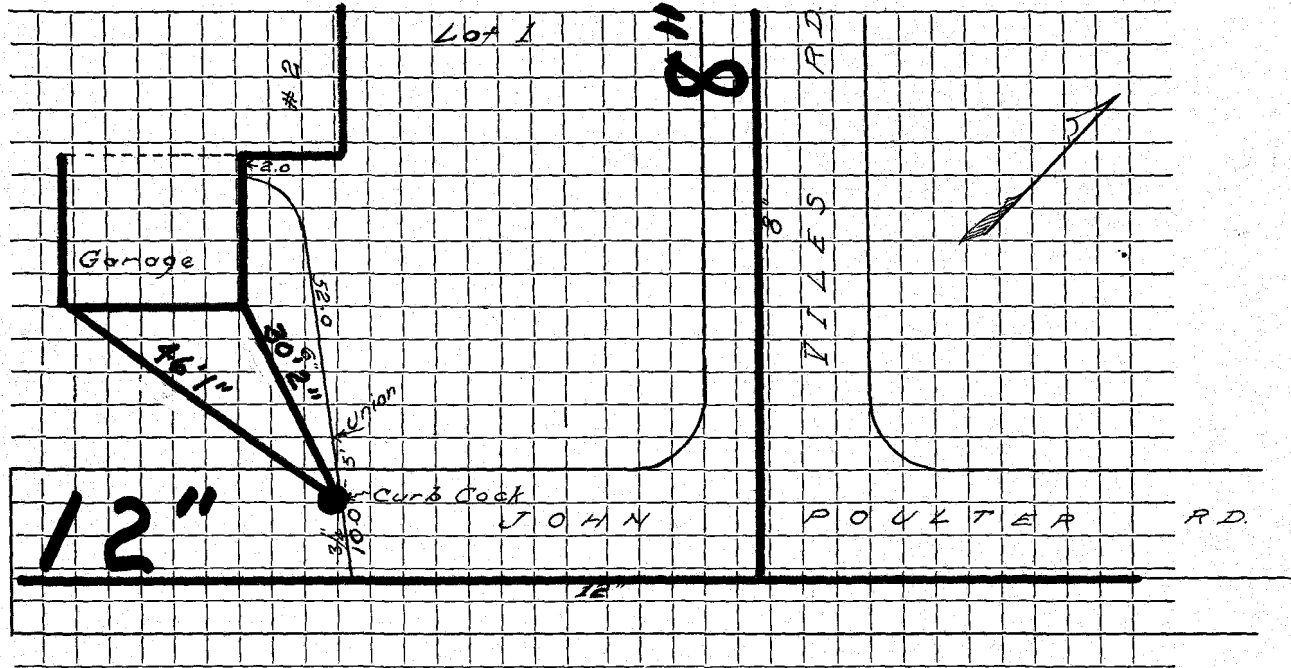

Connection made in Street. Work completed

Remarks:
.....
.....