

WATER SERVICE RECORD

Name **Foley Healty Trust**

Service No. 111

Address **4 Viles Road**

Location **Lot 2 Sta. 2+78**

~~WATER SERVICE~~ **New Service DeFlice Bros - Permit #98**

DEC 28 1964


Date	Material	Amount	Total	Date	Amount	
8-10-62	10' 3/4" Copper tubing @.42 BILL WHEN CONNECTED		4.20 41.29 45.49	9-16-64	Deposit	41.29
10-2-64	39' 3/4" Copper tubing				NON CHARGE	
				60'	3/4" Copper tubing @.42	25.20
				1	3/4" C Corp Cock	4.91
				1	3/4" C Curb Cock	6.28
				1	Box & Rod	4.90
						41.29

DATE _____

TOWN OF LEXINGTON — BOARD OF PUBLIC WORKS

WATER DIVISION

Sketch of Service Here

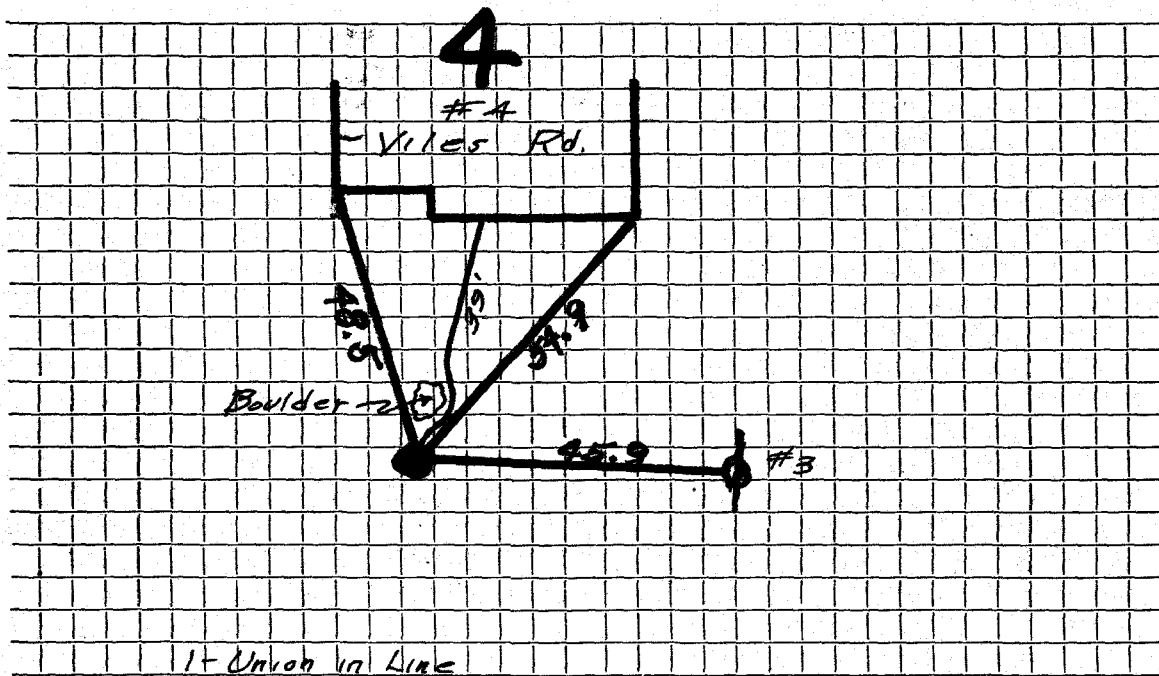

Connection made in Street. Work completed

Remarks:

.....

.....