

## WATER SERVICE RECORD

Name Foley Realty Trust

Service No. 7

Address 5 Viles Road

Location Lot 3 Sta. 2+41

~~Electric Service~~ - New Service DeFlice Bros Permit #212

MAY 17 1965


Date	Material	Amount	Total	Date	Amount
8-10-62	10' 3/4" Copper tubing @.42 BILL WHEN CONNECTED		4.20 47.90 <u>52.10</u>	3-12-65	Deposit 52.10
3-19-65	61' 3/4" Copper tubing		52.10		
				70' 3/4" Copper tubing @.42	29.40
				1 3/4" C 3 part union	2.41
				1 3/4" C Gurb Cock	6.28
				1 3/4" C Corp Cock	4.91
				1 Box & Rod	<u>4.90</u>
					47.90

DATE \_\_\_\_\_

TOWN OF LEXINGTON — BOARD OF PUBLIC WORKS

WATER DIVISION

Sketch of Service Here

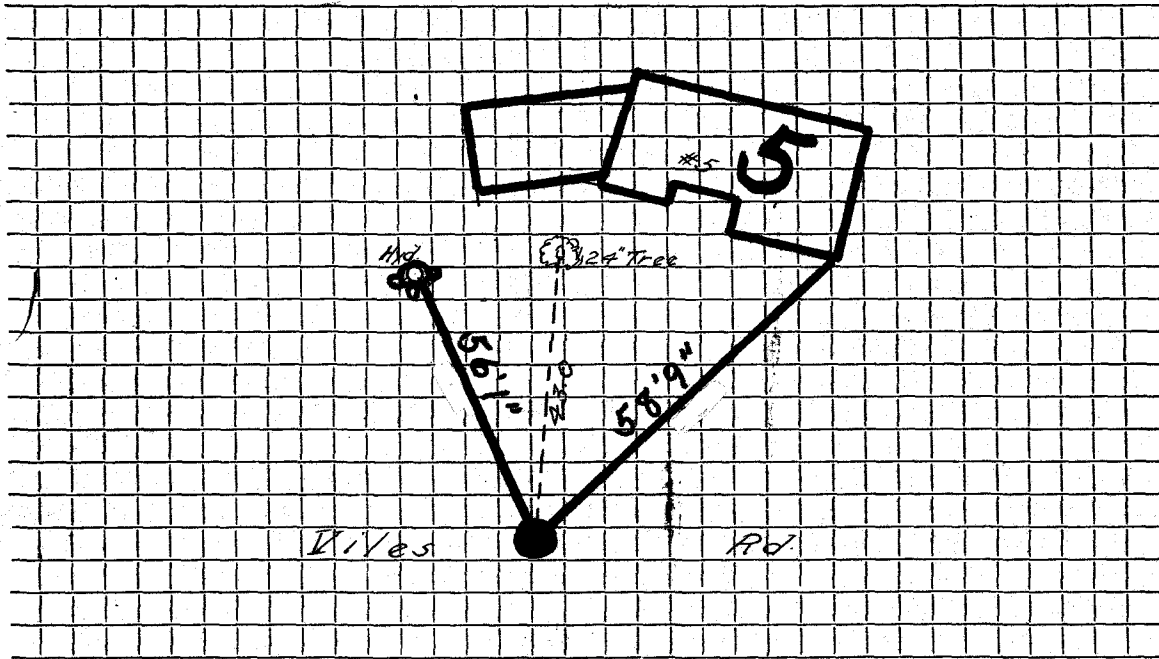

Connection made in ..... Street. Work completed .....

Remarks: .....

.....

.....