

DATE Oct 5-19

TOWN OF LEXINGTON—BOARD OF PUBLIC WORKS WATER DIVISION

The undersigned applies for a supply of water at No. 14 New Court St. and hereby agrees to comply with the rules and regulations as now, or at any future time, established by the Board of Selectmen.

Am't. of Estimate \$ 21.00

Owner


Am't. Paid \$ _____

Address

Sylvia Vance
1728 New Court

Builder _____

Sketch of Service Here

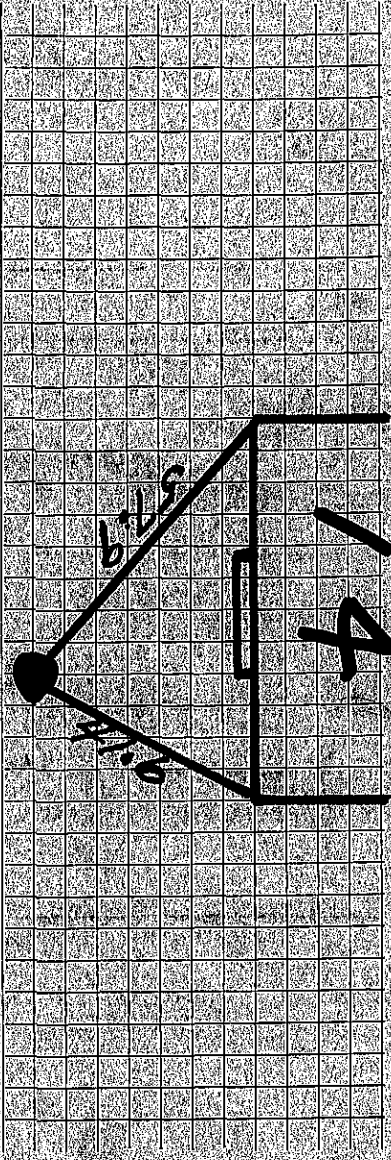

Handwritten signature

0
1
2
3
4
5
6
7
8
9
10