

WATER SERVICE RECORD

Name **George Morse**

Service No. **168**

Address **1 Vine Brook Road**

Location **Lexington, Mass.**

~~XXXXX~~ Renewal ~~XXXXXX~~


Cam. 12-3-51

Date	Material	Amount	Total	Date	Amount
9/24/51	Labor	1 49	1 49	7-20-51	Deposited 10 00
	10% overhead		15	12-31-51	Paid 6 17
	30' - 3/4" copper tubing @ .326	9 78	9 78		16 17
	1 - 3/4" Cx1/2 I.W.H. stop & waste	4 00	4 00		<u>NON CHARGE</u>
	1 hr. trucking		75	9/24/51	Labor 1 49
			16 17	15' - 3/4" copper tubing @ .326	4 89
				1 - 3/4" C. corp-cock	4 33
				1 - 3/4" Cx3/4" C. curb-cock	4 67
				1 box and rod	4 68
				1 - 1/2 offset tail piece	50
				1 - 1/2 straight tail piece	50
				1 hr. trucking	75
					<u>21 81</u>
				<i>bill sent 12-3-51</i>	

DATE _____

TOWN OF LEXINGTON — BOARD OF PUBLIC WORKS
WATER DIVISION

Sketch of Service Here

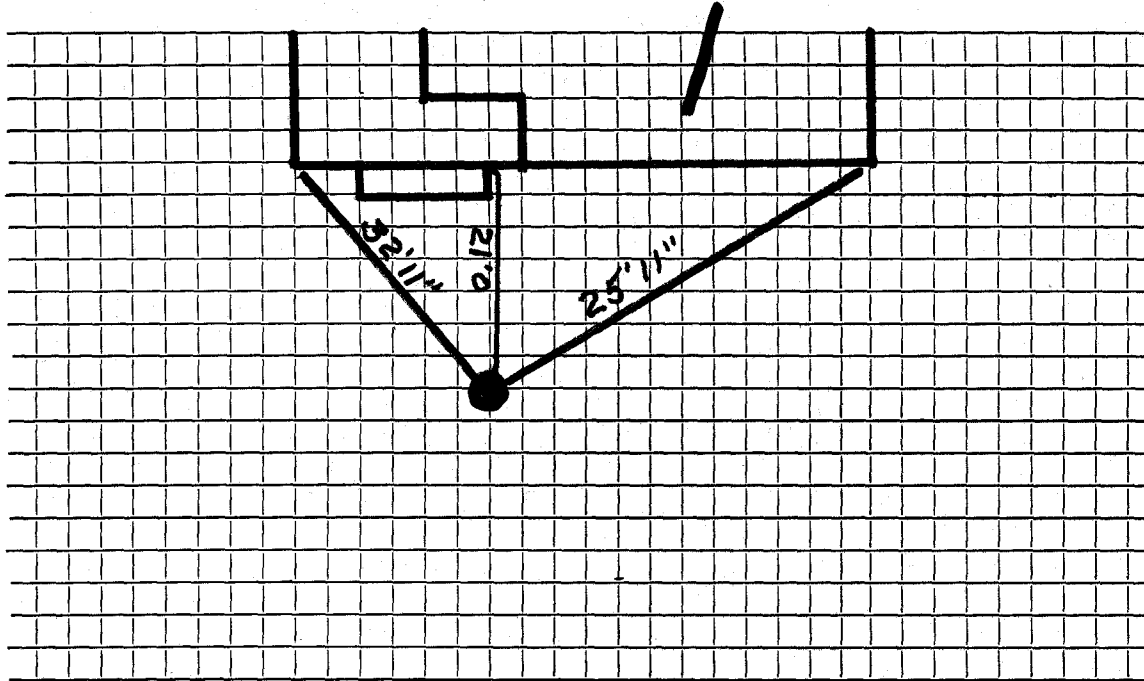

Connection made in Street.

Work completed

Remarks: Original Service 9-14-29

.....
.....