

WATER SERVICE RECORD

Name Joanne R. Rudd

Service No. 21

Address 17 Vine Brook Road

Location

~~Renewal~~ W.O. #4664

JAN 22 1968


Date	Material	Amount	Total	Date	Amount
				5-19-67	150 00
				1-22-68	7 21
5-19 67	Labor	63.94			142 79
	10 % O.H	6.39	70.23		
	44' 3/4" Copper tubing @.79		34.76		
	1 3/4" Wheel Valve		9.30		
	3 Hrs. Trucking @3.00		9.00		
	3 Hrs. Shovel @6.50		19 50		
			142 79		

DATE _____

TOWN OF LEXINGTON — BOARD OF PUBLIC WORKS

WATER DIVISION

Sketch of Service Here

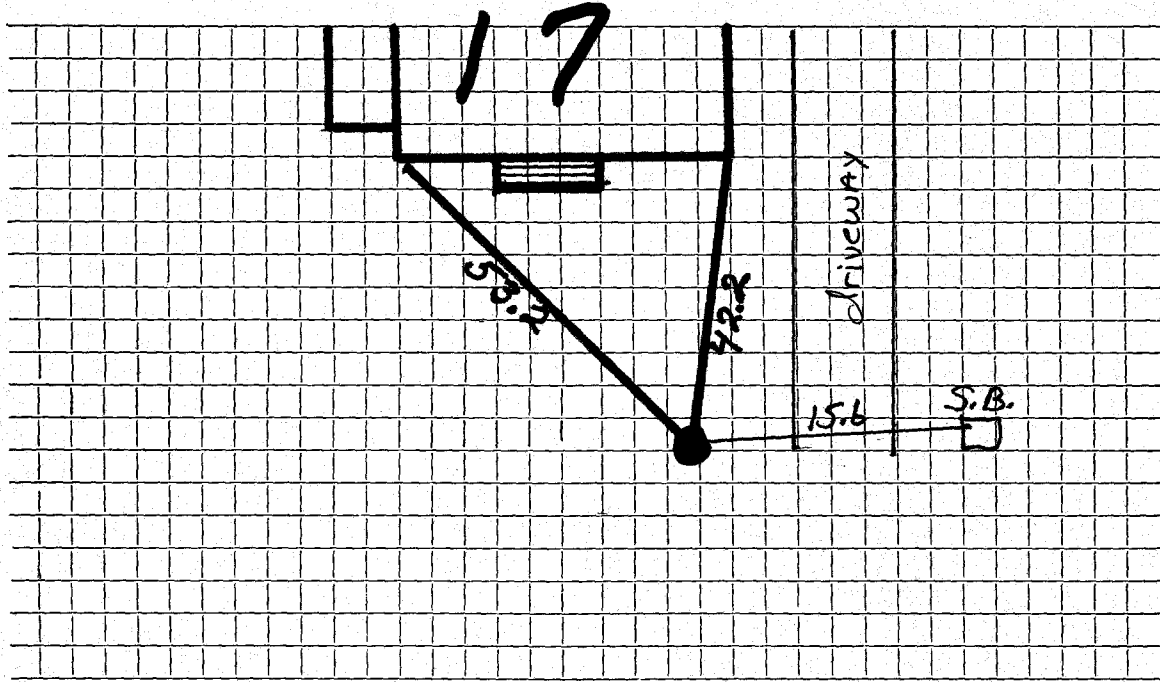

Connection made in Street. Work completed

Remarks:
.....
.....