

WATER SERVICE RECORD

Name Nils W. Nilson

Service No. 347

Address 19 Vine Brook Road

Location Lexington, Mass.


~~Repair—Renewal—New Service~~

Com. 12-31-50

Date	Material	Amount	Total	Date	Amount
Dec. 1, 50	Labor	29 04	29 04	Nov 16 50	50 00
	10% Overhead		2 90	Jan 22 51	48
	42' - 3/4" Copper Tubing @ .334	14 03	14 03		No Charge
	1 - 3/4" C x 1/2" I.W.H. S&W	3 76	3 76		1 - Box & Rod
	Trucking 1 hr. @ .75		75		3 70
			50 48		
	<i>Bills sent 1-12-51</i>			12.8.76	10' • 3/4 Copper
					1 3/4 x 5/8 Corp. Adp.
					1 3/4 Curb
					1 Box + Rod
					1 Ton Cold Patch

TOWN OF LEXINGTON — BOARD OF PUBLIC WORKS
WATER DIVISION

Sketch of Service Here

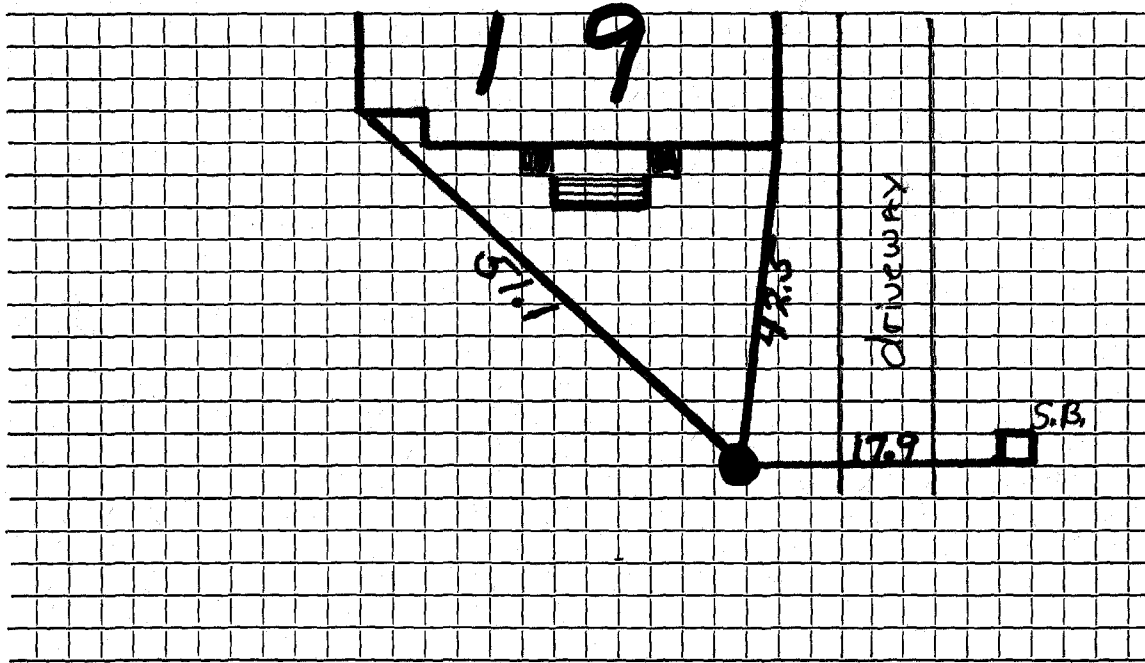

Connection made in Street. Work completed

Remarks:
.....
.....