

Colonial Garage, Inc.

Service No. # 2754

Address

1668 Mass. Avenue

Location

22 Vine Brook Road.

Kind of Pipe

Size

Size of Main

Repair—Renewal—New Service

Location

Date
1941

Material

Amount

Total

Date

Amount

Feb. 24

2 hrs. @ 60¢

1 20

February 8, 1941

Deposited

20 00

10% Overhead

12

1 32

June 13, 1941

Refunded

7 70

42' 3/4" Copper tubing @ 19¢

7 98

1 3/4" C x 1/2" I.S.& W.

2 25

1 hr. trucking

75

12 30

12 30

Credit this refund to Sewer Service #3

Labor

Hadley Press, Inc., Lexington

Com 6/9/41

DATE Feb

TOWN OF LEXINGTON—BOARD OF PUBLIC WORKS

WATER DIVISION

The undersigned applies for a supply of water at No. 22 Vindbocks Rd St. and hereby agrees to comply with the rules and regulations as now, or at any future time, established by the Board of Selectmen.

Am't. of Estimate \$ 200.00 20.00


Owner Colonel George C. Lee

Am't. Paid \$ 25.00

Address Lexington Mass.

Builder J. H. Dwyer

Sketch of Service Here

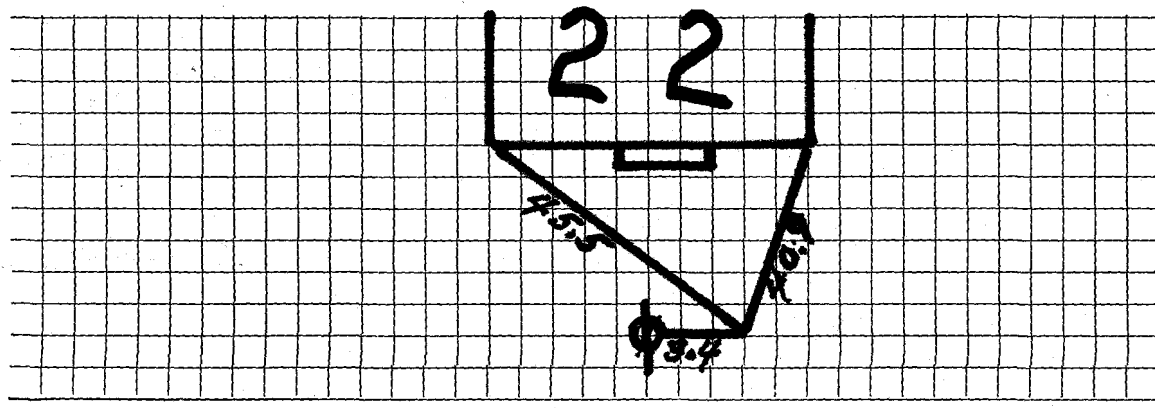

Connection made in _____ Street. Work completed _____ 19

Remarks: