

WATER SERVICE RECORD

Name **Alfred Tropeano**

Service No. **68**

Address **25 Vine Brook Road**

Location

Repair—~~Residual New Service~~ **W. O. # 151**

FEB 12 1973


Date	Material	Amount	Total	Date	Amount
10/3/72	Labor	99 60	109 56	10/6/72	Deposit
	10% O.H.	9 96			125 00
	8' 3/4" Copper pipe	.79	6 32		
	3/4"-3Pt. Union		6 12		
	1 Hr. Truck		3 00		
			125 00		
				40' 3/4" Copper	
				3/4" C x 1/2 I.S.W.	

DATE _____

TOWN OF LEXINGTON — BOARD OF PUBLIC WORKS

WATER DIVISION

Sketch of Service Here

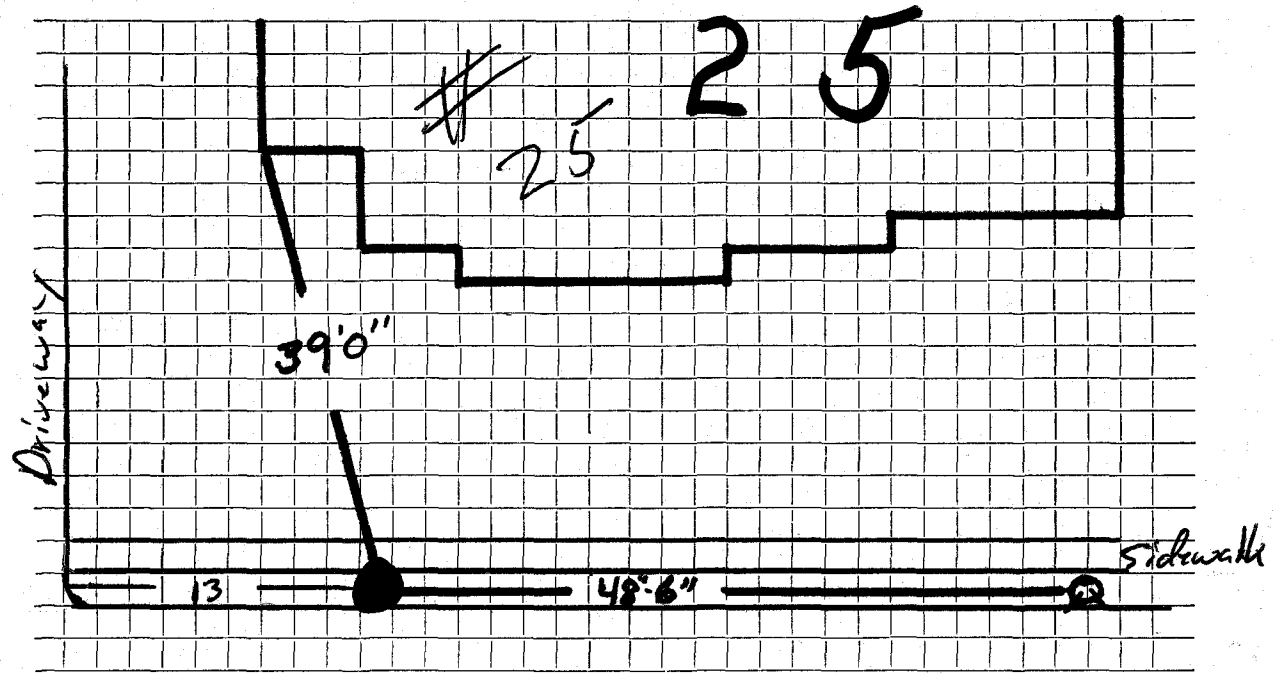

Connection made in Street. Work completed

Remarks:
.....
.....