

Name

Colonial Garage, Inc.

Service No. #

2758

Address

1668 Mass. Ave., Lexington

# 1980

Location

27 Vine Brook Road

Kind of Pipe

Size

Size of Main

Repair—Renewal—New Service

Location

Date 1941	Material	Amount	Total	Date	Amount
Apr. 7	2 hrs. @ 60¢	1 20		April 2, 1941 Deposited	20 00
Com 6/9/41	10% Overhead	12	1 32	June 14, 1941 Refunded	7 89
	41' 3/4" Copper tubing @	19¢	7 79		12 11
	1 3/4" C.x 1/2" I.S. & W.		2 25		
	Trucking - 1 hr. @ 75¢		75		
			12 11		
	(Refund of \$7.89 to be credited to Sewer Service #3)				
	Labor				

DATE April 2, 1941

TOWN OF LEXINGTON—BOARD OF PUBLIC WORKS  
**WATER DIVISION**

The undersigned applies for a supply of water at No. 27 Vine Brook Rd St. and hereby agrees to comply with the rules and regulations as now, or at any future time, established by the Board of Selectmen.

Am't. of Estimate \$ ~~67.00~~


Owner Colonial Garage

Am't. Paid \$ \_\_\_\_\_

Address \_\_\_\_\_

Builder \_\_\_\_\_

Sketch of Service Here

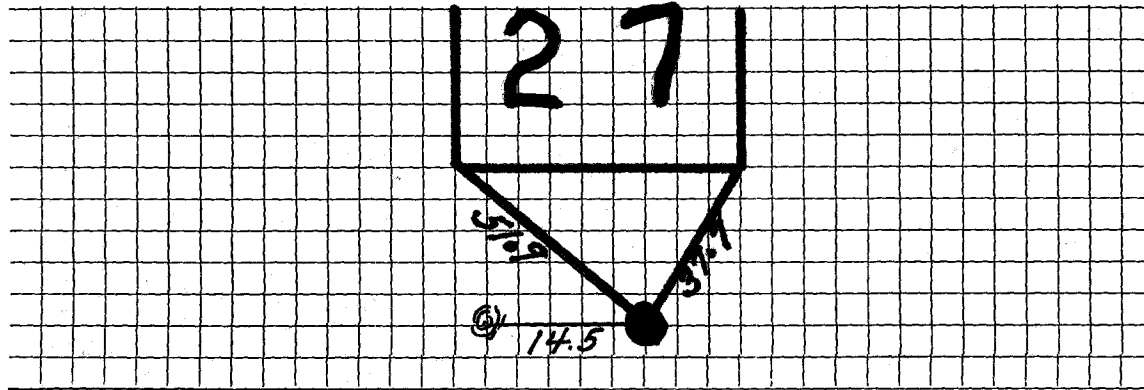

Connection made in \_\_\_\_\_ Street.

Work completed \_\_\_\_\_ 19

Remarks: