


DATE 7-27-95

TOWN OF LEXINGTON — BOARD OF PUBLIC WORKS

WATER DIVISION

Sketch of Service Here

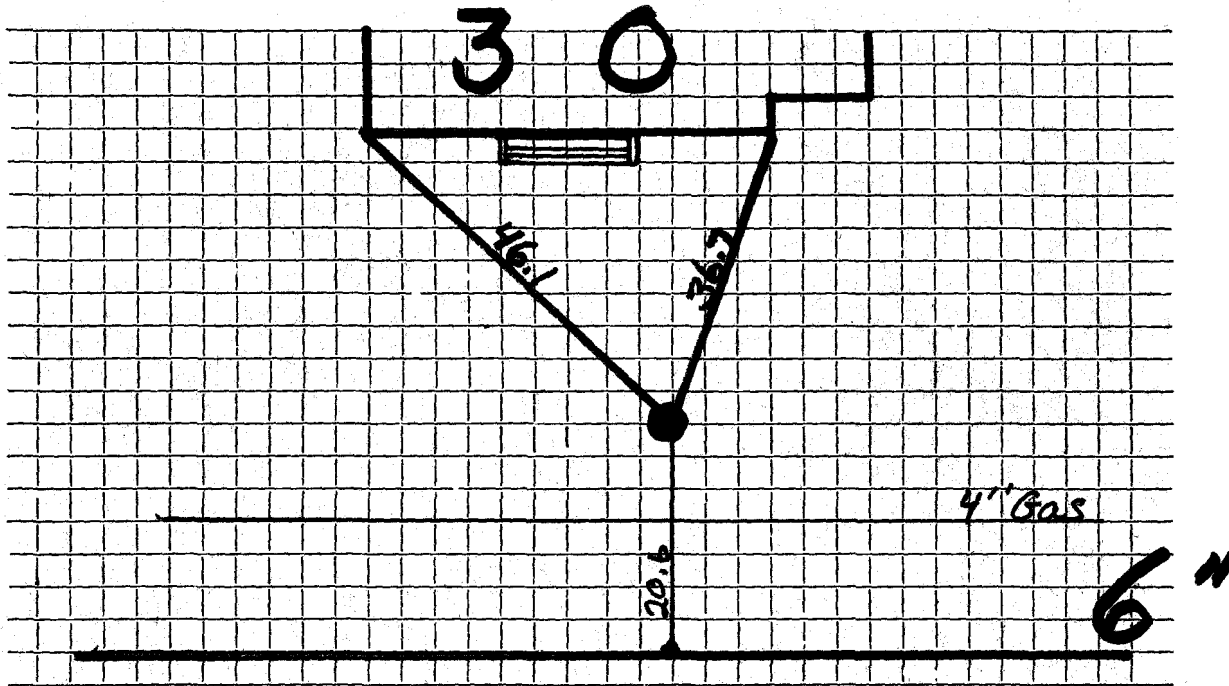

Connection made in Street. Work completed 7-26-95

Remarks: 1\" Copper... 3\" under... 4\" Gas