

Name Eugene Viano

Service No. 2761

Address 1668 Mass. Avenue, Lexington

~~32 Vine Brook Road~~ Location

32 Vine Brook Road

Kind of Pipe

Size

Size of Main

~~Repair~~ ~~Renewal~~ New Service

Location

Date 1941

Material

Amount

Total

Date

Amount

May 6,
Sun. 6/30/41

4 hrs. @ 60¢

2 40

10% Overhead

24

2 64

41' 1" Copper tubing @ 22¢

9 02

1 1" C. S. & W.

2 25

1 1" C. Union (3 part)

1 00

Trucking - 1 hr.

75

15 66

September 1941 Paid

15 66

Rec'd 7/1/41

Labor

DATE _____

TOWN OF LEXINGTON—BOARD OF PUBLIC WORKS

WATER DIVISION

The undersigned applies for a supply of water at No. _____ St. and hereby agrees to comply with the rules and regulations as now, or at any future time, established by the Board of Selectmen.

Am't. of Estimate \$ _____


Owner _____

Am't. Paid \$ _____

Address _____

Builder _____

Sketch of Service Here

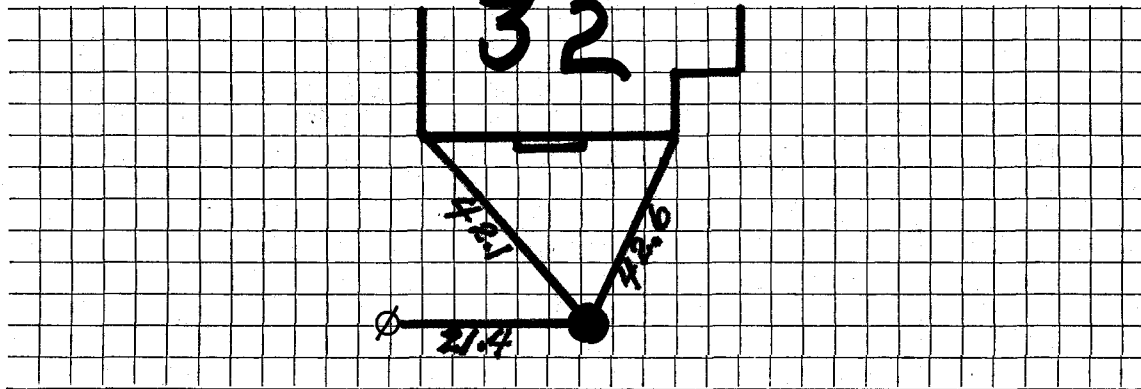

Connection made in _____ Street.

Work completed _____ 19

Remarks: