

Name Herman MacKay

Service No. ~~27~~ 2745

Address 42 Fletcher Ave.,

H. Vine Road Rd

Location 4Vine Brook Road

Kind of Pipe

Size

Size of Main

Repair—Renewal—New Service

Location

Date
1938

Material

Amount

Total

Date

Amount

5/19/38

2 hrs. @ 60¢

1 20

May 12, 1938 Deposited

25 00

38' 3/4" Copper Tubing @ 20¢

7 60

July 17, 1938 Refunded

6 00

1 3/4" ~~1/2~~ Bushing

30

1 3/4" S. & W.

3 75

19. 00

12 85

Flat Rate:

38' @ 50¢

\$19 00

Labor

DATE May 11/38

TOWN OF LEXINGTON—BOARD OF PUBLIC WORKS

WATER DIVISION

The undersigned applies for a supply of water at No. 4 Vine Brook Rd St. and hereby agrees to comply with the rules and regulations as now, or at any future time, established by the Board of Selectmen.

Am't. of Estimate \$ 25.00


Owner German Mackey

Am't. Paid \$ _____

Address 42 Fletcher Ave.

Builder _____

Sketch of Service Here

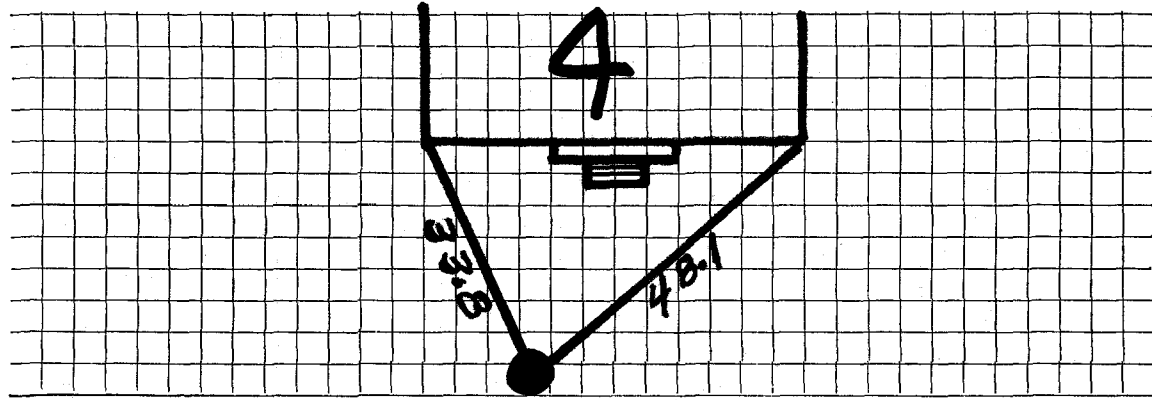

Connection made in _____ Street.

Work completed _____ 19

Remarks: