

WATER SERVICE RECORD

①-6005

782
#4243

Name W. J. McKee

Service No.

80

Address 10-12-14 Vine Street

Location

New Service

~~REPAIR~~ ~~RENEW~~ ~~NEW SERVICE~~

Com. 6-13-55


Date	Material	Amount	Total	Date	Amount
4/9/55	Labor	10 35		3-31-55	Deposited 50 00
	10% overhead	1 04	11 39	6-13-55	Refunded (4 11)
	30' - 1" copper tubing@.4584	13 75	13 75		NON CHARGE 45 89
	1 - 1"C x 1"I.W.H.stop & waste	4 50	4 50	4/9/55	Labor 25 00
	1 hr. Littlefield shovel	7 50	7 50	18'	1" copper tubing@.4584 8 25
	1 hr. trucking	75	75		1 - 1" C. corp-cock 5 61
	patching 8 x 3	8 00	8 00		1 - 1"C x 1"C. curb-cock 6 80
			45 89		1 box and rod 3 90
					1 -1" offset tail pc. 93
					1 - 1" straight tail pc. 93
					3 hrs. Littlefield shovel@ 7.50 22 50
					1 hr. trucking 75
					74 67

DATE _____

TOWN OF LEXINGTON — BOARD OF PUBLIC WORKS

WATER DIVISION

Sketch of Service Here

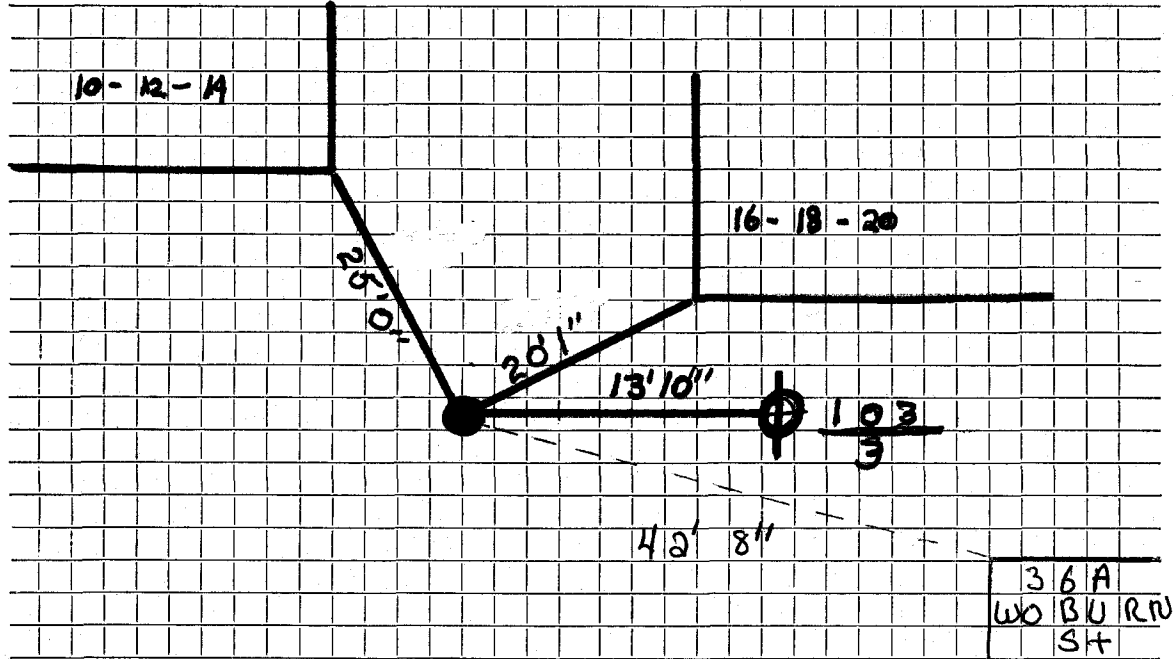

Connection made in Street. Work completed

Remarks:
.....
.....