


DATE _____

TOWN OF LEXINGTON — BOARD OF PUBLIC WORKS

WATER DIVISION

Sketch of Service Here

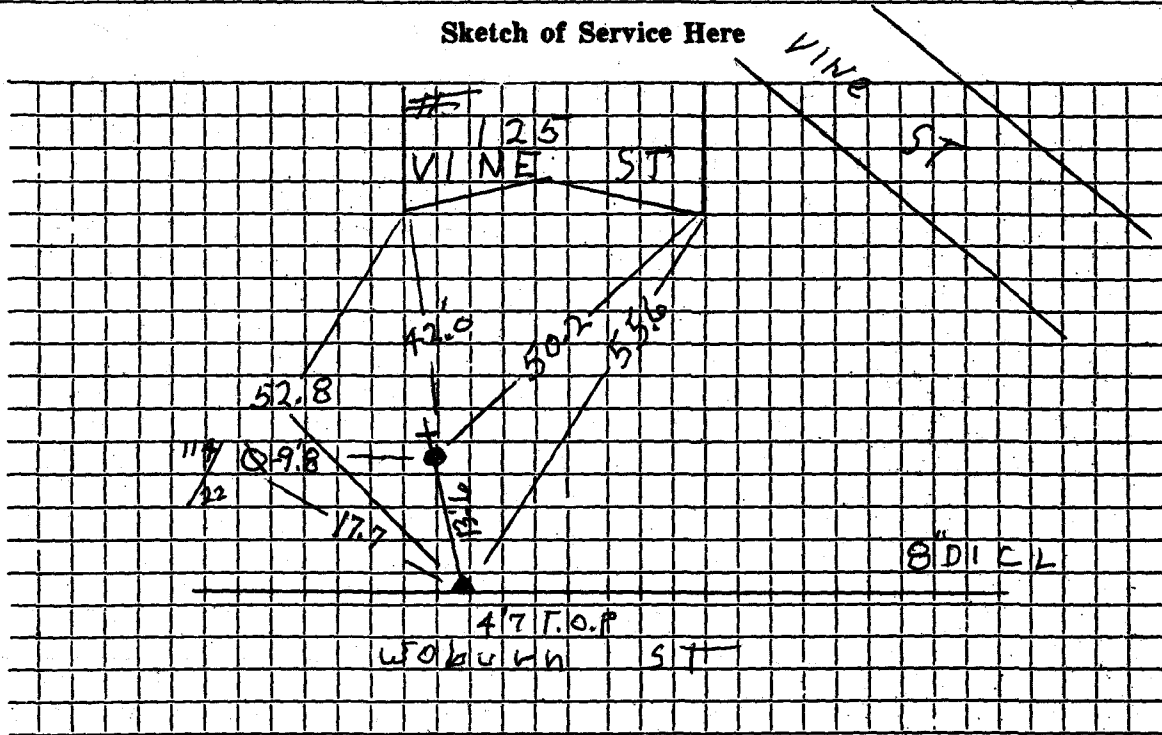

Connection made in Woburn ST Street.

Work completed 9/7/07 Deflice

Remarks:

.....

.....