

WATER SERVICE RECORD

Name *Howard C. Cobb*

Service No. 19

Address *132-134 Vine St.*

Location

Repair—Renewal—New Service Work Order #2257

FEB 10 1975


Date	Material	Amount	Total	Date	Amount	
7-9-74	Labor	\$17.81		7-8-74	Deposit	150 00
8-19-74	Labor (Patch)	\$94.30		6-16-75	Abate	103 23
	10% O.H.	11 21	\$123. 32		Retard	25 94
28'	Copper Pipe 1" @	1. 35	37.80	7/9/74	Labor	52 43
1	1" Wheel Valve		13.79	22'	1" Copper Tubing	
2½	Ton Hot Top @	12 15	30 38	1"	Curb Cock	
2	Hours of Trucking @	3 00	6 00	1"	Corporation	
1	Hour Town Shovel @	6 50	6 50	½	Ton of Coal Patch	
2	Hours Pick Up @	1 50	3 00	2	Hours of Trucking	
1	Hour Roller @	2 00	2 00	2	Hours Town Shovel	
1	Hour Compressor @	5 00	5 00			
			\$227.79			
6-16-75	Abate		103 23			
			124 06			

DATE _____

TOWN OF LEXINGTON — BOARD OF PUBLIC WORKS

WATER DIVISION

Sketch of Service Here

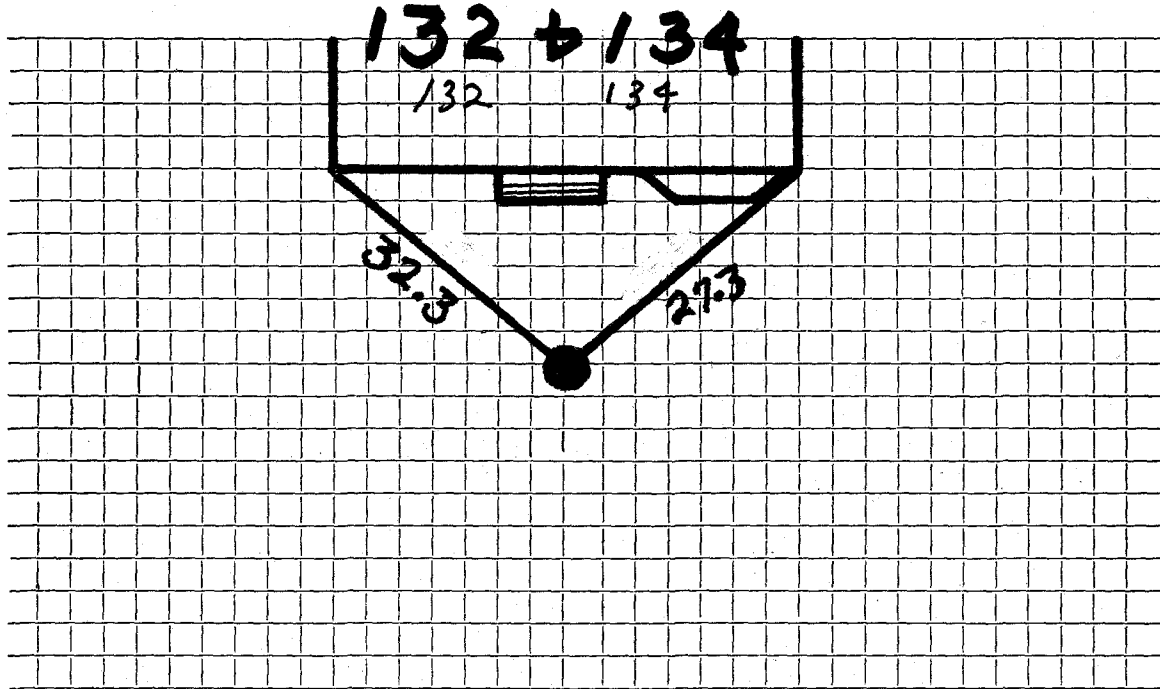

Connection made in Street. Work completed

Remarks:
.....
.....