




DATE \_\_\_\_\_

# TOWN OF LEXINGTON — BOARD OF PUBLIC WORKS

## WATER DIVISION

Sketch of Service Here

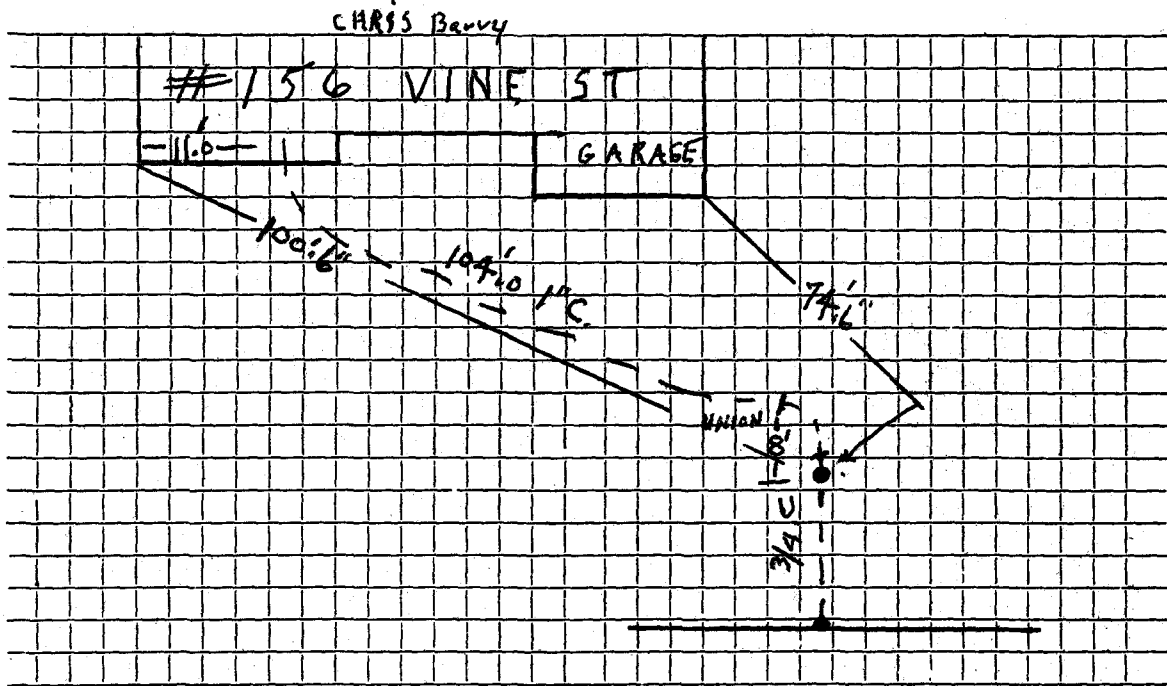

Connection made in ..... Street.

Work completed NOV 04 J. McLaughlin

Remarks: .....  
.....  
.....