Water Service Record

Name		
Address	162 VINE	<u></u>

Service No.

Location


Repair Renewal - New Service

Date	Material	Amount	Total	Date	Amount
10/19/22	1" Type K Copper				
	1" Curbshop				
	Buttalo Box				1. **X

Date: 10/19/22

TOWN OF LEXINGTON - BOARD OF PUBLIC WORKS WATER DIVISON

SKETCH OF SERVICE HERE

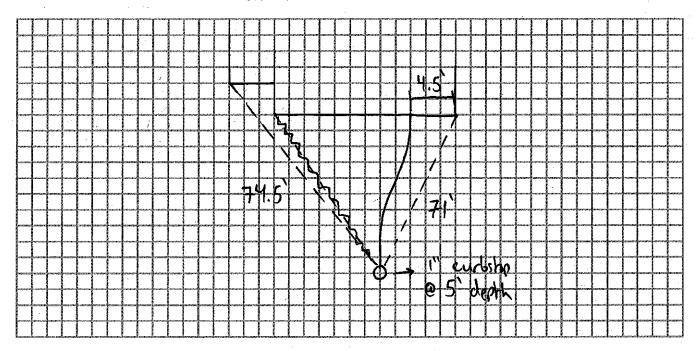

Connection made in:		Street.	Work completed:	MANUTASE SERTU BRUUN MYSUU (YUMANU NEGERSUU NU NUMUU NAAN NA YERI MARKOKI NERVI (M
Remarks: INSTALLED	By C	CM LANDSCAPING	3	NAMI NAMERO NAMERO NAMERO NAMI NAMERO NAMI NAMI NAMI NAMI NAMI NAMI NAMI NAMI
nemen ir ir ir sacisti sacist is sacisti katali kara ir ir isas azat 1944 ir ir is ir sacisti setsadites i kata (katis ir katis ir ir is ir is ir is ir is ir is ir		AND THE REPORT OF THE PROPERTY	स्तरम् ॥ अभारतम् त्रात्रः ॥ ॥ ॥ ॥ ॥ ॥ ॥ ॥ ॥ ॥ ॥ ॥ ॥ ॥ ॥ ॥ ॥ ॥ ॥	