

WATER SERVICE RECORD

Name

Service No.

Address 2 Vine Street

Location

~~Repair~~ Renewal ~~New Service~~


Date	Material	Amount	Total	Date	Amount
6-9-'55	55' 3/4" Copper				
	1 3/4" C. X 1/2" l. w. H. S Top + Waste				
					<u>NON CHARGE</u>
				4/15/54 Labor	30 63
				30' - 3/4" copper tubing @ .35	10 50
				1 - 3/4" C. corp-cock	4 33
				1 - 3/4" C x 3/4" C l curb-cock	4 67
				1 box and rod	3 90
				3 hrs. Littlefield shovel @ 7.50	22 50
				1 hr. trucking	75
				patching 22 x 3	22 00
					99 28

DATE _____

TOWN OF LEXINGTON — BOARD OF PUBLIC WORKS

WATER DIVISION

Sketch of Service Here

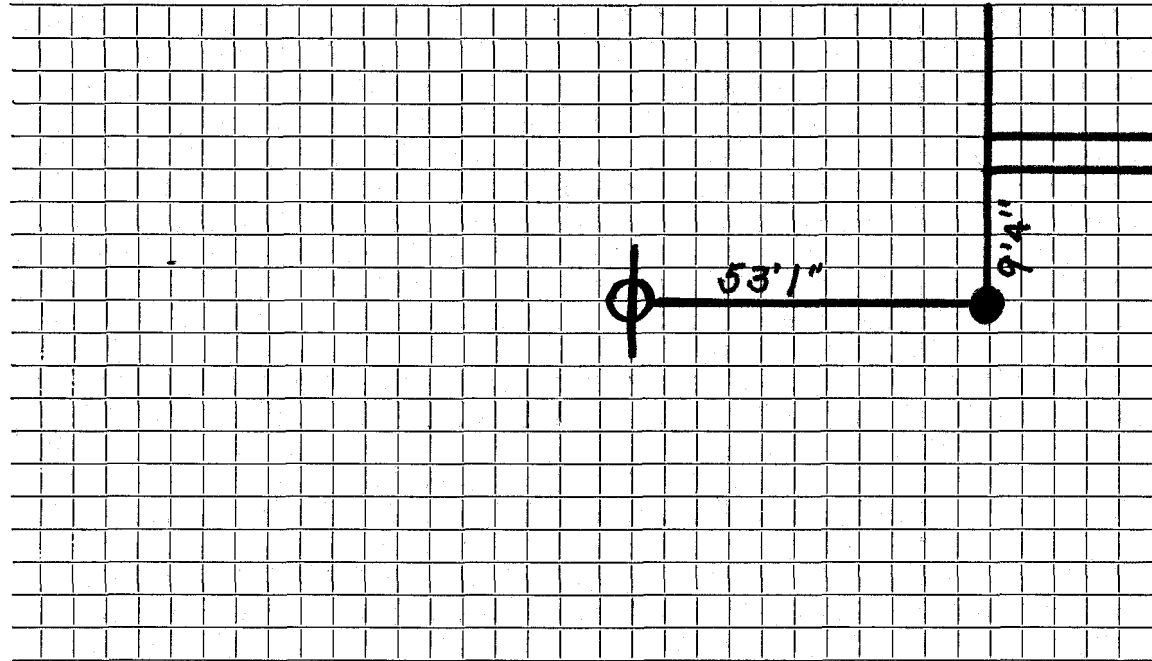

Connection made in Street. Work completed

Remarks:
.....
.....