

WATER SERVICE RECORD

Name Karen Shaw

Service No. 8

Address 21 Vine Street

Location

~~RENEW~~—Renewal—~~New Service~~ W.O. #6252

MAY 22 1978


Date	Material	Amount	Total	Date	Amount
5/1/78	Labor	12.43		5-1-78	150.00
	10% O.H.	1.24	13.67	5-3-78	7.54
10'	3/4" Copper tubing @.83		8.30		42.13
1	3/4" Wheel Handle		17.10		
1	3/4" x 1/2" Reducer		1.56		
1	Ground Clamp		1.50		
6-9-78			42.13		
	8' 3/4" Copper				
	1 3/4" Adapter To lead Corp				
	1 3/4" Curb				
	1 Box + Rod				

DATE _____

TOWN OF LEXINGTON — BOARD OF PUBLIC WORKS

WATER DIVISION

Sketch of Service Here

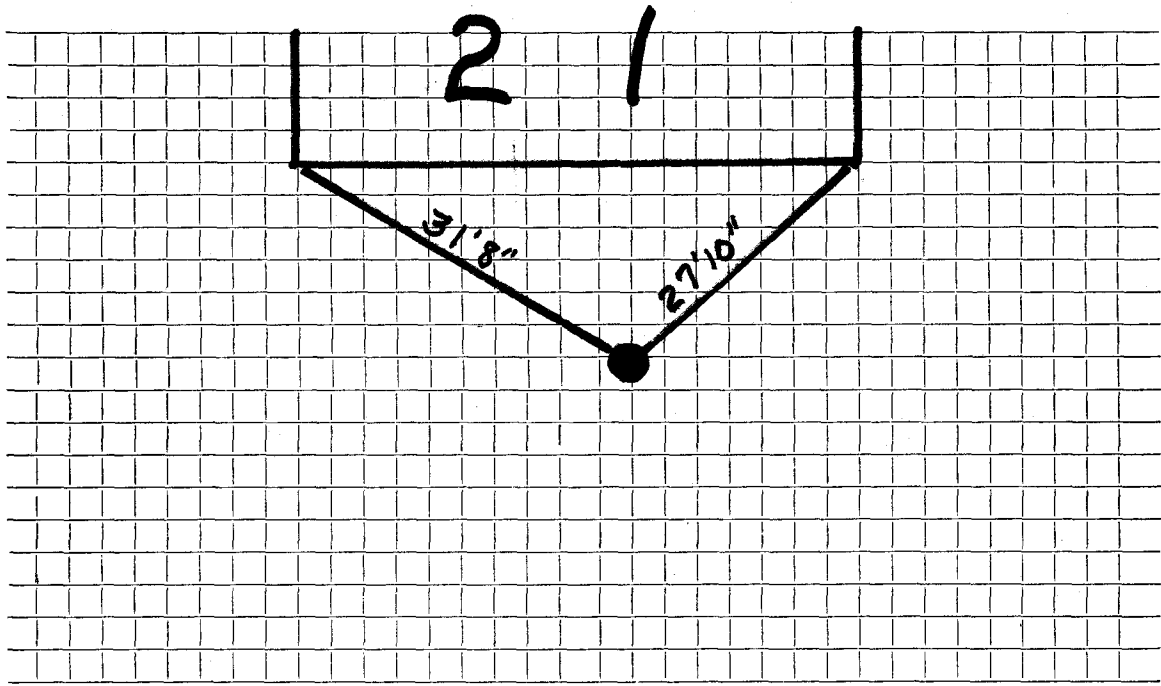

Connection made in Street. Work completed

Remarks:
.....
.....