

Name Theresa McDonnell

Service No.

~~2730~~
#5333
#5485

Address ~~28~~ Vine Street

22

Location

22 Vine Street

Kind of Pipe

Size

Size of Main

~~Repair~~—Renewal—~~New Service~~

Location

Date 1942	Material Chargeable	Amount	Total	Date	Amount
June 11	1 hr. @ 65¢	65			
<i>Com 7/6/42</i>	1 " @ 70¢	70	1 35	<i>July 16 1942 Paid</i>	6 00
	10% Overhead		14		
	6' 3/4" Copper tubing @ 21¢		1 26		
	1 3/4" C.x 1/2" I.W.H.S.& W.		2 50		
	1 hr. trucking		75		
			6 00		
	Curb to Main- Not chargeable				
	Labor		3 75		
17'	1" C.L.Pipe @ 25¢		4 25		
3'	3/4" Copper tubing @ 21¢		63		
1	3/4" Copper corp.cock		2 25		
1	3/4" C x 1" I. Curb cock		2 70		
1	3/4" C. Union (3 parts)		1 31		
1	3/4" C x 1" I. Union		88		
1	Labor		38		
1	Straight Tail piece		38		
1	Offset Tail piece		38		
1	Box and Rod		1 65		
1	Trench repairs		3 34		
			21 52		

Hadley Press, Inc., Lexington

DATE _____

TOWN OF LEXINGTON—BOARD OF PUBLIC WORKS

WATER DIVISION

The undersigned applies for a supply of water at No. _____ St. and hereby agrees to comply with the rules and regulations as now, or at any future time, established by the Board of Selectmen.

Am't. of Estimate \$ _____


Owner _____

Am't. Paid \$ _____

Address _____

Builder _____

Sketch of Service Here

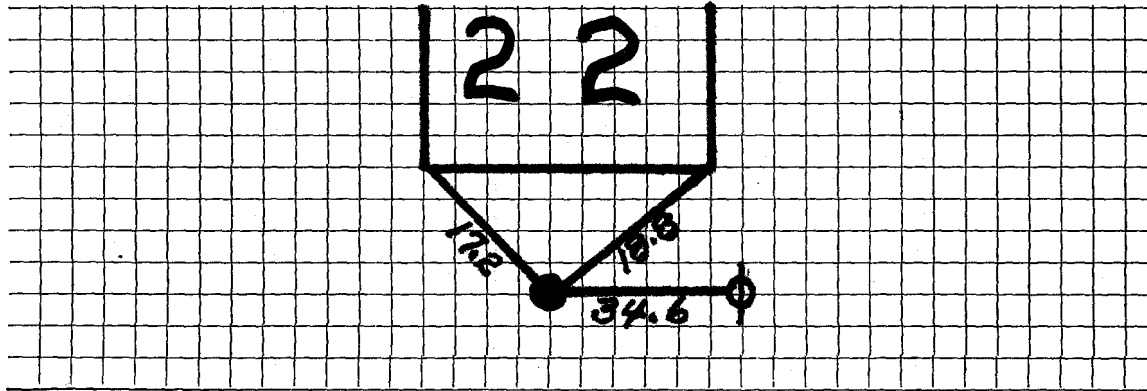

Connection made in _____ Street.

Work completed _____ 19

Remarks: