

Name

Service No. 2731

Address

Location 23 Vine Street

Kind of Pipe

Size

Size of Main

Repair—Renewal—New Service

Location

Date

Material

Amount

Total

Date

Amount

Labor

Hadley Press, Inc., Lexington

DATE \_\_\_\_\_

# TOWN OF LEXINGTON—BOARD OF PUBLIC WORKS

## WATER DIVISION

The undersigned applies for a supply of water at No. \_\_\_\_\_ St. and hereby agrees to comply with the rules and regulations as now, or at any future time, established by the Board of Selectmen.

Am't. of Estimate \$ \_\_\_\_\_

Owner

J. Brown.


Am't. Paid \$ \_\_\_\_\_

Address

23. Vine St.

Builder \_\_\_\_\_

Sketch of Service Here

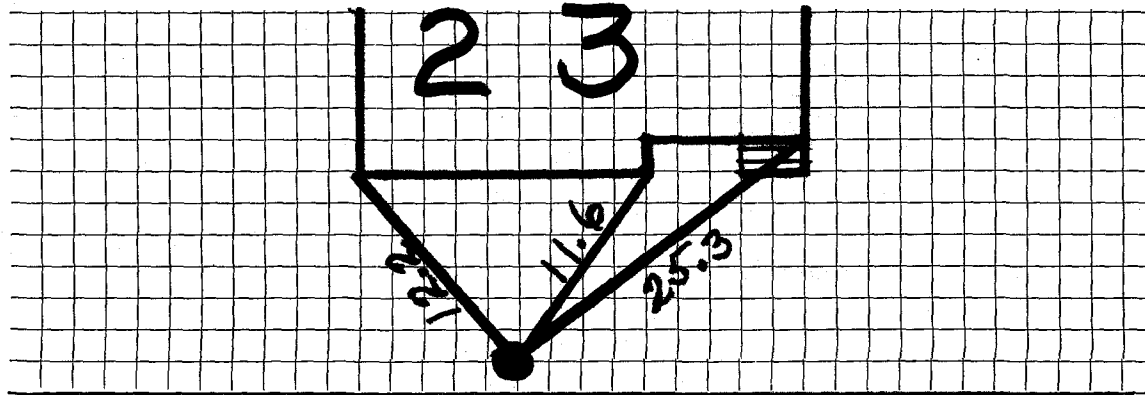

Connection made in Vine Street. St. Work completed \_\_\_\_\_ 19

Remarks: