

## WATER SERVICE RECORD

1312

Name F. Massone

Service No. 85

Address 38 Vina Street

Location

~~Repair Record~~—New Service Trebino Const. Col. Permit #443 W.O. #855

MAR 14 1966


Date	Material	Amount	Total	Date	Amount
9-17-65	Labor	121 03		8-17-65	150 00
9-20-65	Labor	35 07		4-21-66	154 49
	10% O.H.	15 61	171 71		<u>304 49</u>
28'	3/4" copper tubing @ .42		11 76		
1	Curb		8 76		
1	Corp.		7 41		
1	Box & Rod		4 90		
23	Sticks Dynamite @ .27		6 21		
8	Dynamite Caps @ .28		2 24		
6	Hrs. Town Truck @ 3.00		18 00		
9	Hrs. Town Tractor @ 6.50		58 50		
3	Hrs. Compressor @ 5.00		15 00		
			<u>304 49</u>		
1965	24' 3/4" copper tubing				
					Bill sent 154 49

DATE \_\_\_\_\_

TOWN OF LEXINGTON — BOARD OF PUBLIC WORKS

WATER DIVISION

Sketch of Service Here

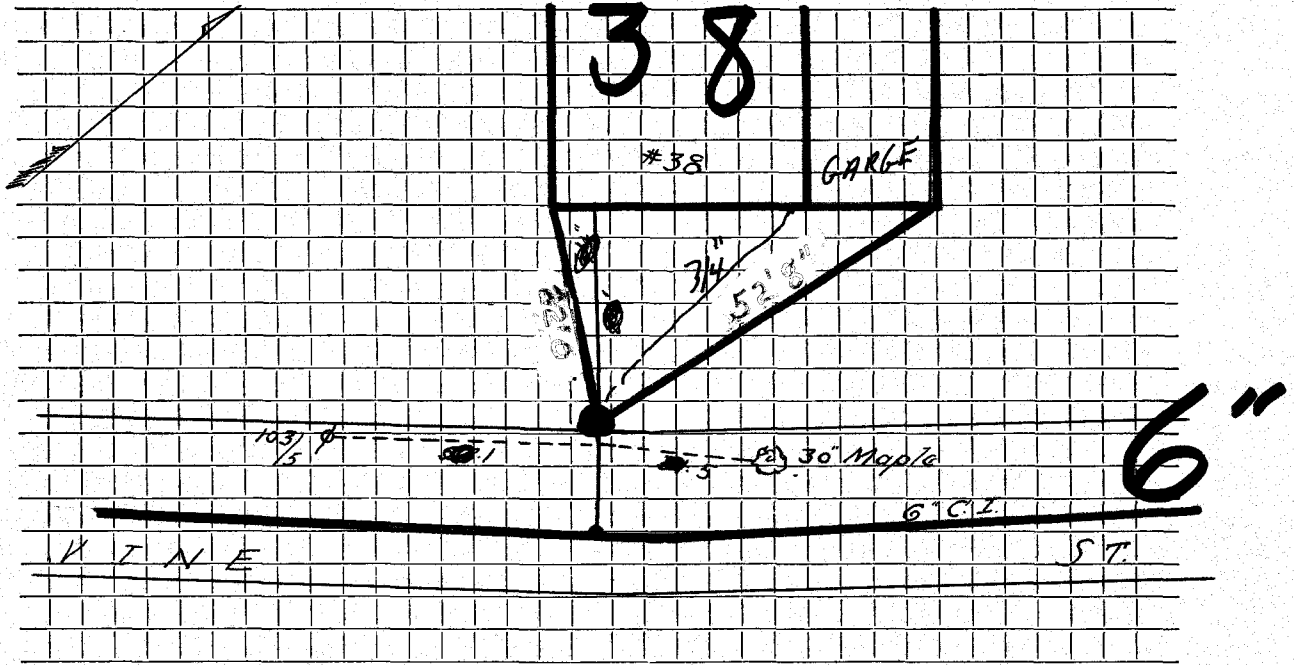

Connection made in ..... Street. Work completed .....

Remarks: ..... 8' DEEP CURB .....

.....  
.....