

## WATER SERVICE RECORD

Name John W. Timbury

Service No. 49

Address 39 Vine Street

Location

Repair—Renewal—New Service Lexington Sewerage Permit #331 W.O. #950

MAR 14 1966


Date		Material	Amount	Total	Date	Amount
9-20-65		Labor	17 15		6-11-65	50 00
		10% O.H.	1 72	18 87	5-14-66	10 09
	12'	3/4" copper tubing @ .42		5 04		39 91
	1	Hr. Town Truck		3 00		
	2	Hrs. Tractor @ 6.50		13.00		
				<u>39 91</u>		
		OUTSIDE				
9-20-65	6'	3/4" copper tubing @ .42		2 52		
9-21-65	11'	3/4" copper tubing				

DATE \_\_\_\_\_

TOWN OF LEXINGTON — BOARD OF PUBLIC WORKS

WATER DIVISION

Sketch of Service Here

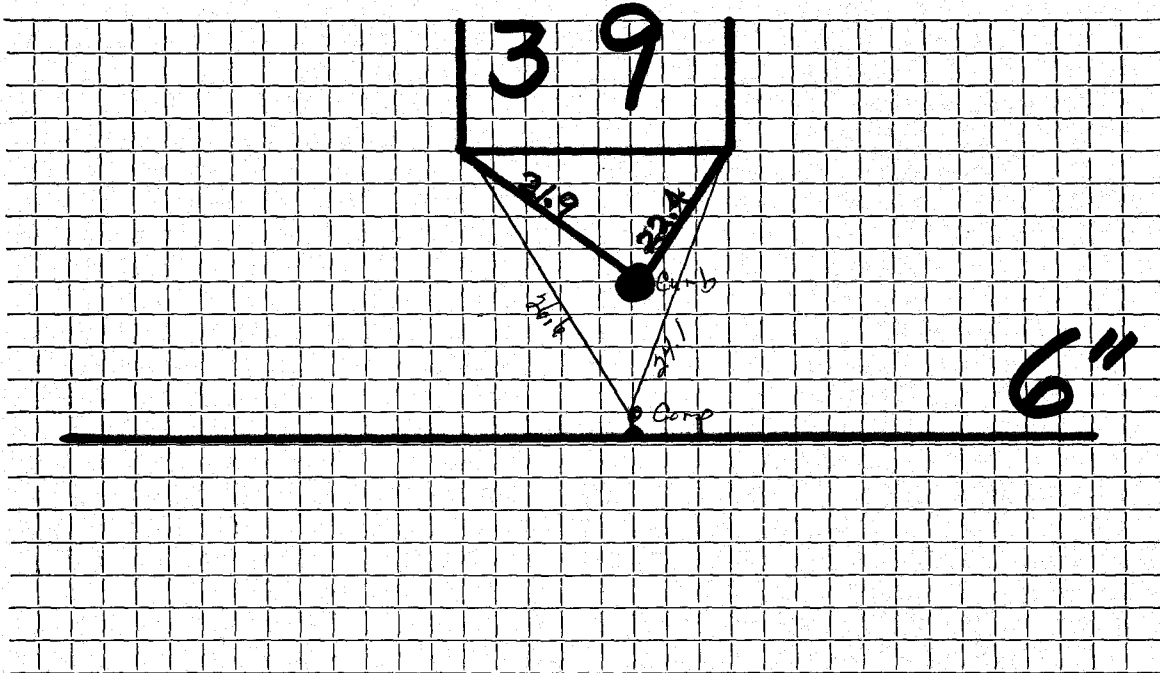

Connection made in ..... Street. Work completed .....

Remarks: .....  
.....  
.....