

WATER SERVICE RECORD

#4945

Name Joseph Trippi

Service No. 82

Address 40 Vine Street

Location

~~PROPERTY RECORD~~ - New Service Trebino Const. Co. Permit #462 W.O. #973

MAR 14 1966


| Date | Material | Amount | Total | Date | Amount |
|---------|------------------------------|--------|-------|------|--------|
| 9-22-65 | Labor | 38 88 | | | |
| | 10% O.H. | 3 89 | 42 77 | | |
| | 23' 3/4" copper tubing @ .42 | | 9 66 | | |
| | 1 3/4" Curb | | 8 76 | | |
| | 1 3/4" Corp. | | 7 41 | | |
| | 1 Box & Rod | | 4 90 | | |
| | 1 Hr. Town Truck | | 3 00 | | |
| | 2 Hrs. Tractor @ 6.50 | | 19 50 | | |
| | | | 96 00 | | |
| 9-23-65 | 16' 3/4" copper tubing | | | | |

DATE _____

TOWN OF LEXINGTON — BOARD OF PUBLIC WORKS

WATER DIVISION

Sketch of Service Here

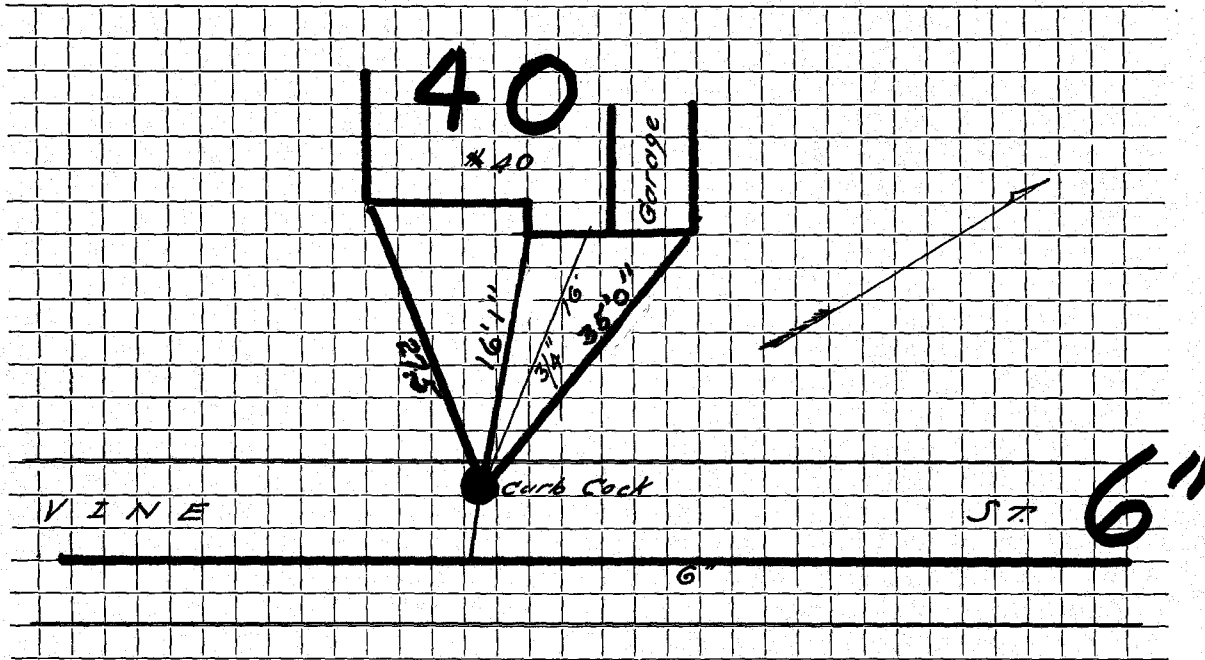

Connection made in Street. Work completed

Remarks:
.....
.....