

Name

Service No. 2734

Address

Location

50 Vine Street

Kind of Pipe

Size

Size of Main

Repair—Renewal—New Service

Location

Date

Material

Amount

Total

Date

Amount

Labor

Hadley Press, Inc., Lexington

DATE _____

TOWN OF LEXINGTON—BOARD OF PUBLIC WORKS

WATER DIVISION

The undersigned applies for a supply of water at No. _____ St. and hereby agrees to comply with the rules and regulations as now, or at any future time, established by the Board of Selectmen.

Am't. of Estimate \$ _____

Owner

J. Swan.


Am't. Paid \$ _____

Address

Nine St. No. 50

Builder _____

Sketch of Service Here

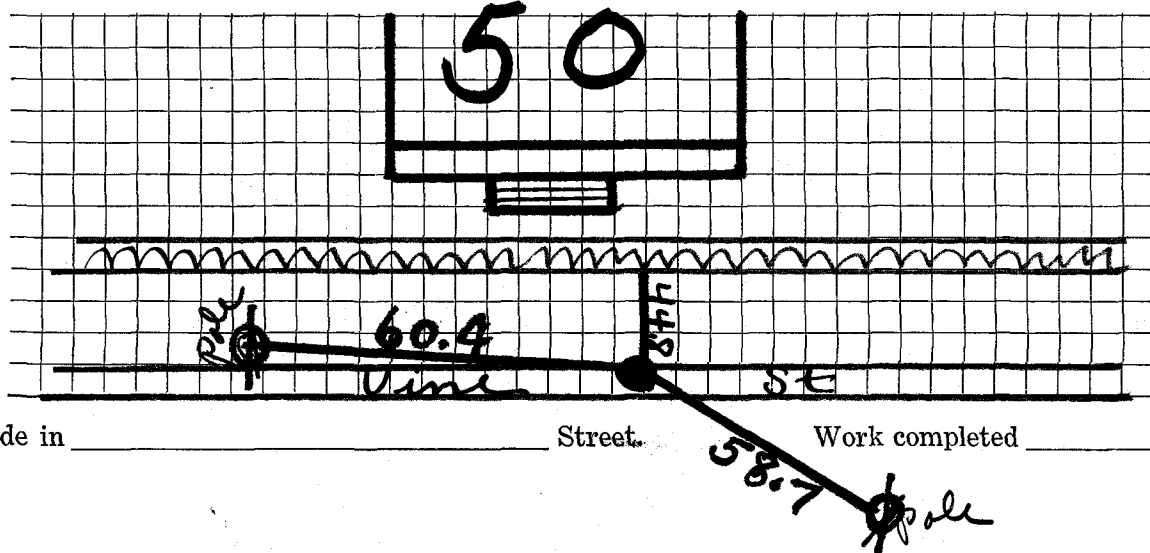

Connection made in _____ Street. Work completed _____ 19

Remarks: