


DATE 9-17-2001

TOWN OF LEXINGTON — BOARD OF PUBLIC WORKS

WATER DIVISION

Sketch of Service Here

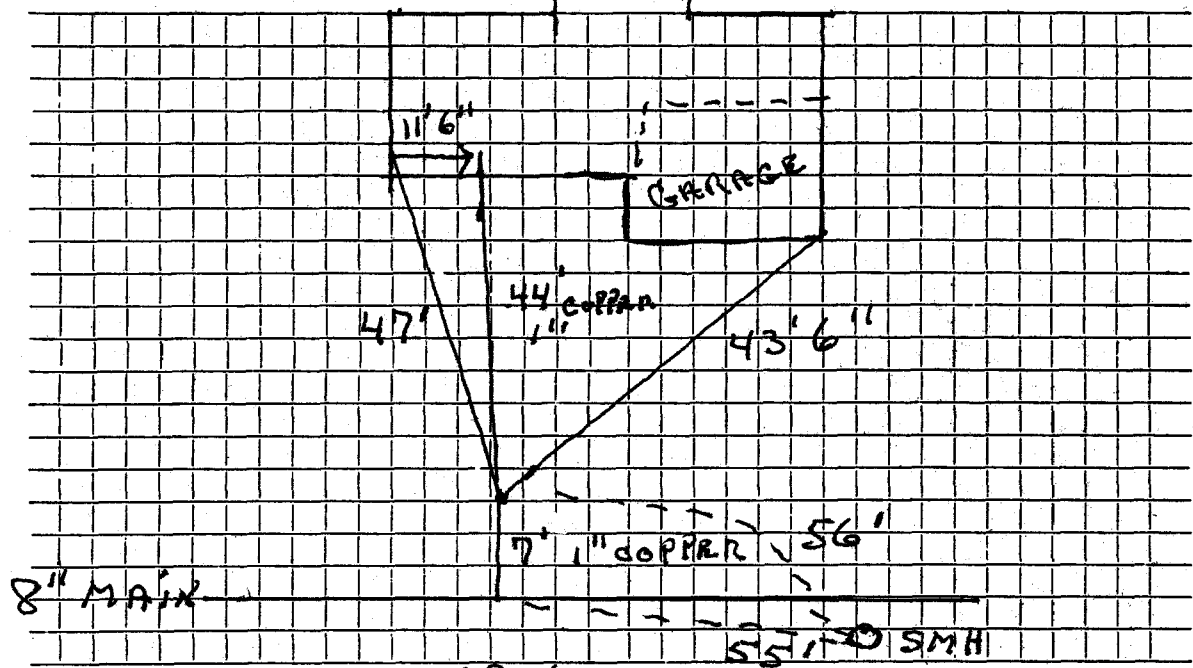

Connection made in VINE Street. Work completed

Remarks: FX. INSTALLED BY J. McLAUGHLIN