

WATER SERVICE RECORD

Name Rose E. Ryan

Service No. 47

Address 55 - 53 Vine Street 2 FmB,

Location

~~Repair - Renewal - New Service~~ W.O. # 9075

NOV 23 1970


Date	Material	Amount	Total	Date	Amount
10/13/70	Labor		29 74	10-13-70	150 00
	10% O.H.		2 97	11-13-70	69 33
34!	3/4" Copper pipe	.79	26 86		80 67
1	3/4" Wheel Valve		9 30		
1/2	Yd. Loam	3.50	1 75		
1/2	Lb. Grass	1.10	55	10/13/70	89 22
1	Hr. Shovel		6 50	10/27/70	22 51
1	Hr. Truck		3 00	7!	5 53
			80 67	1	11 32
				1	2 76
				1/2	3 00
				2	8 00
				1	3 00
				1/2	1 00
					2 00
				2	6 00
					194 34

DATE _____

TOWN OF LEXINGTON -- BOARD OF PUBLIC WORKS

WATER DIVISION

Sketch of Service Here

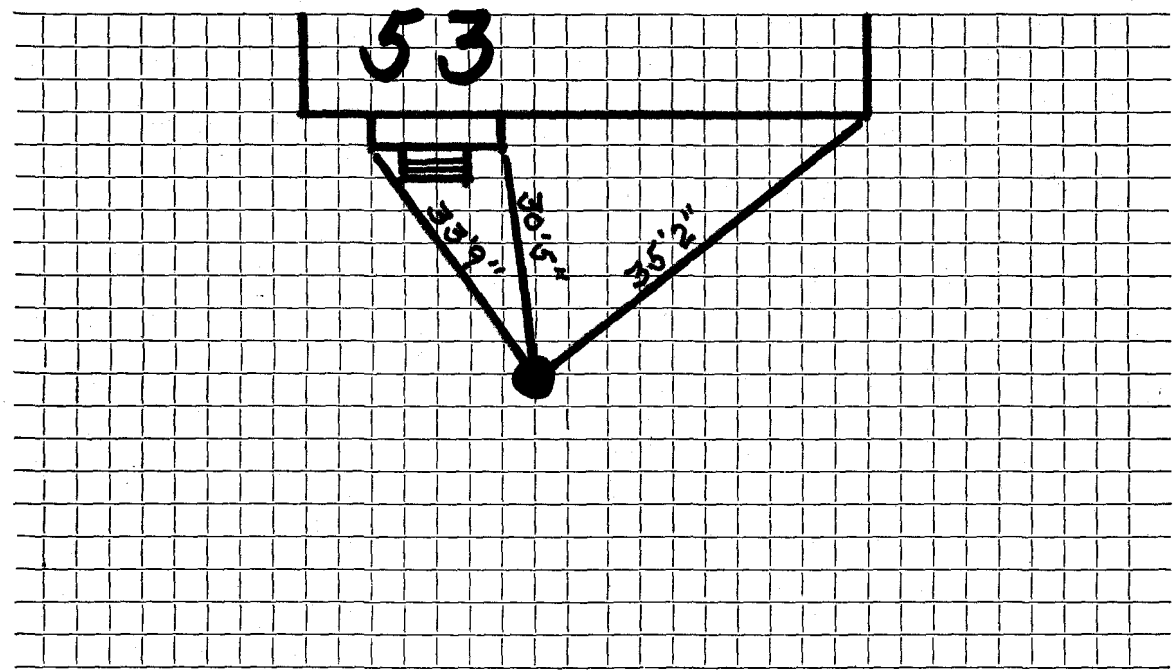

Connection made in Street. Work completed

Remarks: Original Service 7-21-28

.....
.....