

Name *Maud Swan*

Service No. ~~7000015~~ 15

Address

3308

Location

56 Vine Street

Kind of Pipe

Size

Size of Main

~~REPAIR~~—Renewal—~~NBZSREZZEZ~~

W.O. #6252

Location

JUL 7 1969

Date	Material	Amount	Total	Date	Amount
5/8/69	Labor	92 92		5-5-69	400 00
5/21/69	"	2970		7-7-69	125 52
	10% O.H.	1226	134 88		274 48
85'	3/4" Copperpipe .79		67 15		
1	3/4" Union		3 05	5/9/69	Labor 78 96
1	3/4" Wheel Valve		9 30	5/30/69	" 26 31
1	Roll Insulation		5 00		24' 3/4" Copperpipe .79 18 96
2	Yds. Gravel 1.40		2 80		1 3/4" Curb Cock 11 32
3	Yds. Load 3.50		10 50		1 3/4" Adaptor Box & Rod 5 10
3	Lbs. Grass seed 1.10		3 30		1 Ton cold patch 5 50
2	Hrs. Trucking 3.00		6 00		1 " hot top 5 80
5	" Shovel 6.50		32 50		3 1/2 Hrs. trucking 3.00 10 50
	Labor		274 48		1/2 " " 1.50 7 75
					2 " shovel 4.00 8 00
					1" compressor 4.00 4 00
					1 " Roller & trailer 5 00
					182 96

*Deposit
Retained*

OUTSIDE

Hadley Press, Inc., Lexington

DATE _____

TOWN OF LEXINGTON—BOARD OF PUBLIC WORKS

WATER DIVISION

The undersigned applies for a supply of water at No. 56 Vine Street St. and hereby agrees to comply with the rules and regulations as now, or at any future time, established by the Board of Selectmen.

Am't. of Estimate \$ _____

Owner _____


Am't. Paid \$ _____

Address _____

Builder _____

56

Sketch of Service Here

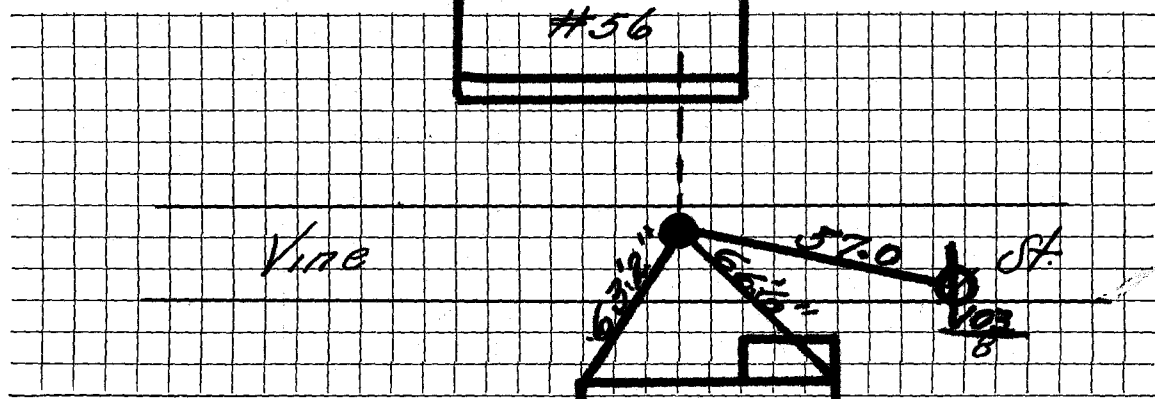

Connection made in _____

Street #55

Work completed _____ 19

Remarks: